

JUDITH D. ROEHM

IP

LAND CORNER RECORDATION CERTIFICATE

Ontonagon County

Page 1 of 1 LC 5/261

Filing Requirement of Act 74, Mich. P.A. 1970

DEC 12/21/1999

Time 11:12:44

RECORDING FEE:

9.00

For corners in

| Ontonagon County                   | Located in:   | Corner Code # |
|------------------------------------|---------------|---------------|
| 1. Public Land Survey              | T51N R39W     | C - 6         |
|                                    | T R           |               |
|                                    | T R           |               |
|                                    | T R           |               |
| 2. Property Controlling in Section | S T R         |               |
|                                    | S T R         |               |
| 3. Miscellaneous Property in Sec.  | S T R         |               |
|                                    | S T R         |               |
| 4. Lot No.                         | Recorded Plat |               |
| 5. Private Claims                  |               |               |

SURVEY & REMONUMENTATION

MAR 23 2000

SECTION

Register of Deeds Stamp & File Number

|    | A  | B | C  | D | E  | F | G  | H | I  | J | K  | L | M |
|----|----|---|----|---|----|---|----|---|----|---|----|---|---|
| 1  |    |   |    |   |    |   |    |   |    |   |    |   |   |
| 2  | 6  |   | 5  |   | 4  |   | 3  |   | 2  |   | 1  |   |   |
| 3  |    |   |    |   |    |   |    |   |    |   |    |   |   |
| 4  | 7  |   | 8  |   | 9  |   | 10 |   | 11 |   | 12 |   |   |
| 5  |    |   |    |   |    |   |    |   |    |   |    |   |   |
| 6  | 18 |   | 17 |   | 16 |   | 15 |   | 14 |   | 13 |   |   |
| 7  |    |   |    |   |    |   |    |   |    |   |    |   |   |
| 8  | 19 |   | 20 |   | 21 |   | 22 |   | 23 |   | 24 |   |   |
| 9  |    |   |    |   |    |   |    |   |    |   |    |   |   |
| 10 | 30 |   | 29 |   | 28 |   | 27 |   | 26 |   | 25 |   |   |
| 11 |    |   |    |   |    |   |    |   |    |   |    |   |   |
| 12 | 31 |   | 32 |   | 33 |   | 34 |   | 35 |   | 36 |   |   |
| 13 |    |   |    |   |    |   |    |   |    |   |    |   |   |

I, Joseph C. Domitrovich, in a field survey on December 8, 1999, do hereby state that under requirements of P.A. 74, Michigan P.A. of 1970, the corner points mentioned in lines 1 and 2 above were in conformance with regulations and rules therefore as required in the current manual of survey instructions of the United States Department of the Interior, Bureau of Land Management or by a decree of a Court of Law and for that the corner points mentioned in lines 3, 4 and 5 above were in conformance with the rules of the Michigan Board of Land Surveyors or by a Decree of a Court of Law; established, re-established, monumented, recovered, found as expressed below:

NOTE: Not more than 2 corners, all in the same town and range, may be recorded on this certificate.

A. Description of original monument and accessories and/or subsequent restoration:

(C - 6) 1/4 Corner Common to Sections 17 & 18, T51N, R39W

1845 Austin Burt set an Ironwood Post with ties:

|            |        |          |
|------------|--------|----------|
| 8" Hemlock | S 36°W | 13 links |
| 10" Sugar  | N 66°E | 9 links  |

No Date Mead Woodlands corner notes indicate a 4" balsam post at the corner with a yellow tag on a 3" Red Maple, N 66°E, 7'.

B. Description of corner evidence found and/or method applied in restoring or reestablishing corner:

I found no remains of the original 1/4 corner or accessories. I found the Balsam Post and the yellow tag called for by Mead. The yellow tag was a Forest Service location poster with "Appx. 1/4 cor. 21 Apr. 71" written on it. The Balsam post is now fallen. The post falls 3.7' East and 13.0' South of a single prorated position. The yellow tag falls 1.3' West and 9.8' South of a single prorated position. I did not accept either the post or the tag. I believe the single proportionate position best represents the original GLO 1/4 corner position and have placed a monument at that position.


Research on file with County Remonumentation Representative.

DEED GROUP REPRESENTATIVE  
Paul W. Appelkamp  
COUNTY SUPERVISOR 12-20-99

C. Description of monument for corner and accessories established to perpetuate locating the position of the corner:

Corner is a 1/4" x 36" aluminum rod with a 3" diameter aluminum cap stamped to read: COUNTY REMONUMENTATION; T51N, R39W; 1/4; S.18, S.17; 1999; P.S. 37273. Corner falls 3' West of a blazed and ribboned line to the South. Ties:

|                      |              |                 |
|----------------------|--------------|-----------------|
| 6" Basswood          | N 13°W       | 25.65'          |
| 7" Soft Maple        | N 45°E       | 19.85'          |
| 5" Hard Maple        | S 15°W       | 0.89'           |
| 6" Hard Maple        | S 77°W       | 33.87'          |
| Steel Sign Rail      | N 45°W       | 1.40' (to face) |
| NE Corner Section 18 | N 00°04'52"W | 2636.78'        |
| SE Corner Section 18 | S 00°04'52"E | 2636.78'        |

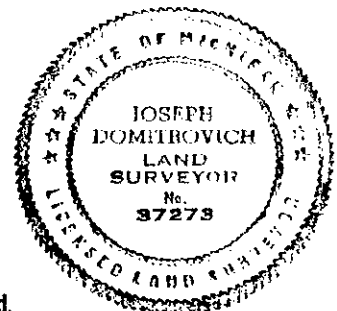

NOTE: Bearings to witness objects are magnetic. Distances are to a nail in side of the witness object unless noted.

Signed by Joseph C. Domitrovich

Date 12/14/99

Surveyor's Michigan License No. 37273