


LAND CORNER RECORDATION CERTIFICATE
 Filing Requirement of Act 74, Mich. P.A. 1970

For corners in

<u>Ontonagon</u> (County)	Located In:	Corner Code #
1. Public Land Survey	T <u>51N</u> R <u>39W</u>	<u>C-7</u>
	T <u> </u> R <u> </u>	<u> </u>
	T <u> </u> R <u> </u>	<u> </u>
	T <u> </u> R <u> </u>	<u> </u>
2. Property Controlling in Section	S <u> </u> T <u> </u> R <u> </u>	<u> </u>
	S <u> </u> T <u> </u> R <u> </u>	<u> </u>
3. Miscellaneous Property in Sec.	S <u> </u> T <u> </u> R <u> </u>	<u> </u>
	S <u> </u> T <u> </u> R <u> </u>	<u> </u>

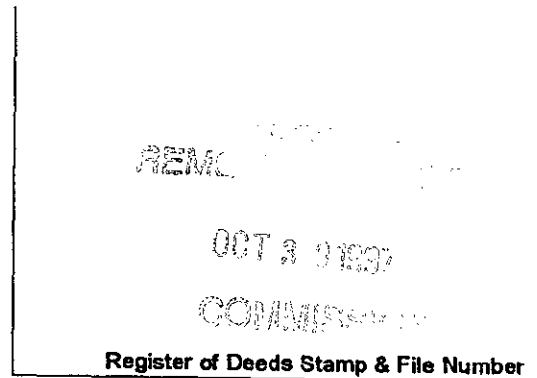

4. Lot No. _____, Recorded Plat _____
 5. Private Claims _____

I, Joseph C. Domitrovich, in a field survey on April 21, 19 97 do hereby state that under requirements of P.A. 74, Michigan P.A. of 1970, the corner points mentioned in lines 1 and 2 above were in conformance with regulations and rules therefore as required in the current manual of survey instructions of the United States Department of the Interior, Bureau of Land Management or by a decree of a Court of Law and/or that the corner points mentioned in lines 3, 4 and 5 above were in conformance with the rules of the Michigan Board of Land Surveyors or by a Decree of a Court of Law, established, re-established, monumented, recovered, found as expressed below:

A	B	C	D	E	F	G	H	I	J	K	L	M
1												
2	6		5		4		3		2		1	
3												
4	7		8		9		10		11		12	
5												
6	18		17		16		15		14		13	
7												
8	19		20		21		22		23		24	
9												
10	30		29		28		27		26		25	
11												
12	31		32		33		34		35		36	
13												

NOTE: Not more than 2 corners, all in the same town and range, may be recorded on this certificate.

(C-7) Corner of Sections 17, 18, 19, and 20 T51N, R39W

A. Description of original monument and accessories and/or subsequent restoration:

- 1846 - Austin Burt set sugar post, 10" Hemlock S 51° E 11 links, 12" Hemlock N 32° W 16 links
- 1947 - U.S. 45 R.O.W. drawings show corner 5292.62' west of Northeast Corner of Section 20.
- 1965 - Michigan State Highway Department, U.S. 45 Highway plans show corner being 5292.62' west of Northeast corner of Section 20 and call corner a 2" wood Hub. They also gave bearings and distances to 3 witness objects.

B. Description of corner evidence found and/or method applied in restoring or reestablishing corner:

I found no remains of original corner. Corner falls in heavily logged area. I found no remains of the M.S.H.D. wood hub but recovered two M.S.H.D. bearing trees. The 6" poplar is now a dead 8" stub. The 3" maple is now a 7" soft maple with numerous blazes and a "1993 M.F.B." Aluminum tag on it. I reestablished the corner using recovered M.S.H.D. bearing trees. This position works well with GLO and Highway plans distances to the Northeast corner of Section 20.

Research on file with County Remonumentation Representative.

C. Description of monument for corner and accessories established to perpetuate locating the position of the corner:

Corner is a 2" x 30" aluminum pipe with a 3" diameter aluminum cap stamped to read: County Remonumentation Station T51N, R39W; S. 18, S. 17, S. 19, S. 20; 1997; P.S. 37273. Corner falls 11 feet south of a SE-NW logging road.

Witnesses

7" Soft Maple	S 78° E	9.40'
Steel Fence Post	South	1.00' to face
3" Balsam	S 12° W	9.11'
6" Soft Maple	S 78° W	18.23'
7" Triple Soft Maple	N 58° W	10.37'
NE Corner Section 20	East	5289.51' (5289.2 GLO)

PEER GROUP APPROVED
Carl W. Applbaum
 COUNTY REPRESENTATIVE
 5-12-97



NOTE: Bearings are magnetic. Distances are to nail in side of witness objects unless noted.

Signed by Joseph C. Domitrovich Date 5/12/97
 Surveyor's Michigan License No. 37273