

LAND CORNER RECORDATION CERTIFICATE  
Filing Requirement of Act 74, Mich. P.A. 1970  
Ontonagon County Remonumentation Corner

Ontonagon County

Page 1 of 1

LC

5-223

REC. Date 09/09/99 Time 15:40  
RECORDING FEE: 9.00

For corners in

Ontonagon County	Located in:	Corner Code #
1. Public Land Survey	T51N R39W	D-3
	T R	
	T R	
	T R	
2. Property Controlling in Section	S T R	
	S T R	
3. Miscellaneous Property in Sec.	S T R	
	S T R	
4. Lot No. , Recorded Plat		
5. Private Claims		

SURVEY & REMONUMENTATION  
MAR 28 2000  
SECTION

Register of Deeds Stamp & File Number

	A	B	C	D	E	F	G	H	I	J	K	L	M
1													
2	6	5		4		3		2		1			
3		●											
4	7	8		9		10		11		12			
5													
6	18	17		16		15		14		13			
7													
8	19	20		21		22		23		24			
9													
10	30	29		28		27		26		25			
11													
12	31	32		33		34		35		36			
13													

I, Joseph C. Domitrovich, in a field survey on August 23, 1999, do hereby state that under requirements of P.A. 74, Michigan P.A. of 1970, the corner points mentioned in lines 1 and 2 above were in conformance with regulations and rules therefore as required in the current manual of survey instructions of the United States Department of the Interior, Bureau of Land Management or by a decree of a Court of Law and for that the corner points mentioned in lines 3, 4 and 5 above were in conformance with the rules of the Michigan Board of Land Surveyors or by a Decree of a Court of Law; established, re-established, monumented, recovered, found as expressed below:

NOTE: Not more than 2 corners, all in the same town and range, may be recorded on this certificate.

A. Description of original monument and accessories and/or subsequent restoration:

(D-3) 1/4 Corner Common to Sections 5 and 8, T51N, R39W.

1845 - Austin Burt set a Sugar Post  
6" Birch S 30° E 47 links  
22" Lynn N 85° W 22 links

1985 - Earl W. Applekamp P.S. 17610 recorded a Survey in Liber 1 Page 79 of Surveys, which shows a 5/8" iron pin at the East 1/16th corner between Sections 5 and 8. The 1/4 corner is not shown.

B. Description of corner evidence found and/or method applied in restoring or reestablishing corner:

I found no remains of the original corner or accessories. I re-established the 1/4 corner by single proportionate measurement between Section corners to the East and West. This position works well with the 5/8" capped Earl Applekamp Iron recovered at the 1/16th corner one quarter mile to the east. Distances to Section Corners East and West work very well with GLO.

Research on file with County Remonumentation Representative.


C. Description of monument for corner and accessories established to perpetuate locating the position of the corner:

Corner is a 2 1/2" aluminum pipe with a 3" diameter aluminum cap stamped to read: COUNTY REMONUMENTATION; T.51N., R.39W.; 1/4 S.5, S.8; 1999; P.S. 37273. Corner falls 45 feet East of a North - South logging road.

Ties:

4" Ironwood	N 42°W	4.58'
10" Soft Maple	S 88° E	38.37'
4" Hard Maple	S 23° E	5.73'
Steel Sign Rail	N 72° W	1.23' (to face)
NE Corner Sec. 8	S89°50'36"E	2638.91' (2637.36' GLO)
NW Corner Sec. 8	N89°50'36"W	2638.91' (2637.36' GLO)

NOTE: Bearings to witness objects are magnetic. Distances are to a nail in side of the witness object unless noted.

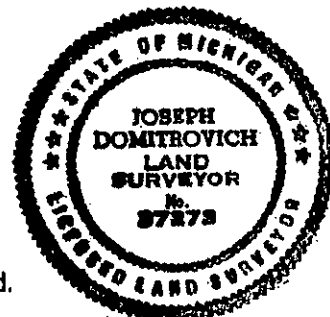

DEED GROUP APPROVAL

Earl W. Applekamp 8-24-99  
COUNTY REPRESENTATIVE

Signed by J. C. Domitrovich

Date 8/24/99

Surveyor's Michigan License No. 37273