

LAND CORNER RECORDATION CERTIFICATE

Filing Requirement of Act 74, Mich. P.A. 1970

Ontonagon County Remonumentation Corner

Ontonagon County of 1 LC 5/211 REC. Date 07/27/99 Time 14:59 RECORDING FEE: 9.00

For corners in

Table with columns: Ontonagon County, Located in:, Corner Code #. Rows include Public Land Survey, Property Controlling in Section, Miscellaneous Property in Sec., Lot No., and Private Claims.

SURVEY & REMONUMENTATION

MAR 23 2000

SECTION

Register of Deeds Stamp & File Number

Section grid table with columns A-M and rows 1-13. A dot is marked in the center of the grid at the intersection of E and 4.

I, Joseph C. Domitrovich, in a field survey on July 15, 1999, do hereby state that under requirements of P.A. 74, Michigan P.A. of 1970, the corner points mentioned in lines 1 and 2 above were in conformance with regulations and rules therefore as required in the current manual of survey instructions of the United States Department of the Interior, Bureau of Land Management or by a decree of a Court of Law and /or that the corner points mentioned in lines 3, 4 and 5 above were in conformance with the rules of the Michigan Board of Land Surveyors or by a Decree of a Court of Law; established, re-established, monumented, recovered, found as expressed below:

NOTE: Not more than 2 corners, all in the same town and range, may be recorded on this certificate.

A. Description of original monument and accessories and/or subsequent restoration:

(E-3) Corner Common to Sections 4, 5, 8, and 9, T51N, R39W.

1845 - Austin Burt set a sugar post

- 24" Hemlock S42°W 39 links
12" Sugar N35°E 42 links

1966 - C. C. Lindgren, P.S. 14098, set 1" iron pipe in the center of Woodspur Road as part of a survey for M-38 Highway Right-of-Way (Michigan State Highway Department Witness record card on file at Ontonagon County Register of Deeds).

- 5" Maple N60°E 60.03'
12" Elm S55°E 63.98'
4" Maple N75°W 25.26'

PEER GROUP APPROVED
Earl W Applekamp 7-20-99
COUNTY REPRESENTATIVE

B. Description of corner evidence found and/or method applied in restoring or reestablishing corner:


I found no remains of the original corner or accessories. I also found no remains of Lindgren's 1" iron pipe or Earl Applekamp's 5/8" iron pin. Woodspur road has been reconstructed since 1985. I recovered one of Lindgren's bearing trees. I used this bearing tree and Lindgren's distance from the NE corner of section 5 to recreate his corner position. This position works reasonably well with the remaining Right-of-Way irons from Earl Applekamp's survey. It also works well with other corners to the West. I accepted and Monumented this position as the Section Corner.

Research on file with County Remonumentation Representative.

C. Description of monument for corner and accessories established to perpetuate locating the position of the corner:

Corner is a 5/8" iron pin with a 3" diameter aluminum cap stamped to read: COUNTY REMONUMENTATION: T.51N, R39W., S. 4, S.5, S.8, S.9; 1999; P.S. 37273. Corner falls 3' West of present centerline of Woodspur Road. I also established a Reference Monument (R.M.) to the East, a 2 1/2" x 30" aluminum pipe with a 3" diameter aluminum cap stamped to indicate that the section corner is N89°02'W, 36.30'. Ties:

- Twin 3" Soft Maples S71°W 34.40'
Stump of 6" Maple N59°E 60.03' (M.S.H.D. B.T.)
11" Soft Maple N82°E 55.78'
R.M. S89°02'13"E 36.30'
Power Pole S60°E 37.61'
NW Corner of Sec. 5 N00°13'48"W 5243.73 (M.S.H.D. & Measured)

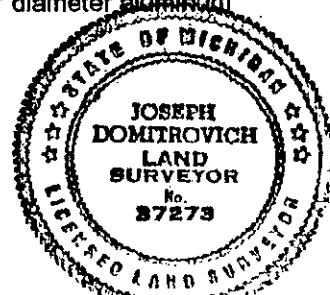

NOTE: Bearings to witness objects are magnetic. Distances are to a nail in side of the witness object unless noted.

Signed by [Signature]

Date 7/20/99

Surveyor's Michigan License No. 37273