

LAND CORNER RECORDATION CERTIFICATE
Filing Requirement of Act 74, Mich. P.A. 1970
Ontonagon County Remonumentation Corner

Page 1 of 1
Ontonagon County LC 5-224
Rec. Date 09/09/99 Time 15:41
RECORDING FEE 9.00

For corners in

Table with 3 columns: Ontonagon County, Located in:, Corner Code #. Includes entries for Public Land Survey, Property Controlling in Section, Miscellaneous Property in Sec., Lot No., and Private Claims.

SURVEY & REMONUMENTATION

MAR 23 2000

SECTION

Register of Deeds Stamp & File Number

Section grid table with columns A-M and rows 1-13. A dot is marked at the intersection of column E and row 4.

I, Joseph C. Domitrovich, in a field survey on August 22, 1999, do hereby state that under requirements of P.A. 74, Michigan P.A. of 1970, the corner points mentioned in lines 1 and 2 above were in conformance with regulations and rules therefore as required in the current manual of survey instructions of the United States Department of the Interior, Bureau of Land Management or by a decree of a Court of Law and/or that the corner points mentioned in lines 3, 4 and 5 above were in conformance with the rules of the Michigan Board of Land Surveyors or by a Decree of a Court of Law; established, re-established, monumented, recovered, found as expressed below:

NOTE: Not more than 2 corners, all in the same town and range, may be recorded on this certificate.

A. Description of original monument and accessories and/or subsequent restoration:

(E-4) 1/4 Corner Common to Sections 8 and 9, T51N, R39W.

- 1845 - Austin Burt set a Sugar Post
6" Hemlock S 58° W 37 links
12" Sugar N 19° E 33 links

B. Description of corner evidence found and/or method applied in restoring or reestablishing corner:

I found no remains of the original corner or accessories. At the 1/4 corner position I found a North - South Paved road (Woodspur Road) running along the section line. I found no other evidence of the corner position. I reestablished the 1/4 corner position midway between Section Corners to the North and South and on centerline of Woodspur Road. This position works well with GLO distances North and South.


Research on file with County Remonumentation Representative.

C. Description of monument for corner and accessories established to perpetuate locating the position of the corner:

Corner is a 5/8" iron pin with a 3" diameter brass cap stamped to read: COUNTY REMONUMENTATION; T.51N, R.39W; 1/4; S.8, S.9; 1999; P.S. 37273. Corner falls on centerline of Woodspur Road. I also established a Reference Monument (R.M.) to the east; a 3/4" x 48" aluminum rod with a 3" diameter aluminum cap stamped to indicate that the 1/4 corner is N88°20'W 31.16'.

Ties:

Table listing ties: Power Pole (S 15° E 117.81'), 10" Poplar (S 89° W 33.22'), 10" Poplar (N 40° W 53.31'), R.M. (S 88°19'42" E 31.16'), NE Corner of Sec. 8 (N 00°19'16" W 2631.12'), SE Corner of Sec. 8 (S 00°13'59" E 2631.12')

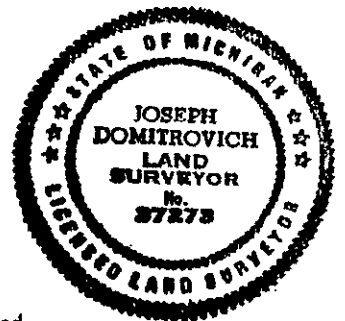

NOTE: Bearings to witness objects are magnetic. Distances are to a nail in side of the witness object unless noted.

DEED GROUP APPROVAL

Signature of Carl W. Applekamp dated 8-24-99, County Representative.

Signed by J.C. Domitrovich

Date 8/24/99

Surveyor's Michigan License No. 37273