

LAND CORNER RECORDATION CERTIFICATE
Filing Requirement of Act 74, Mich. P.A. 1970
Ontonagon County Remonumentation Corner

Page 1 of 1
LC 54 225
Rec. Date 09/09/99 Time 15:42
RECORDING FEE: 9.00

For corners in

Table with columns: Ontonagon County, Located in:, Corner Code #. Rows include Public Land Survey, Property Controlling in Section, Miscellaneous Property in Sec., Lot No., and Private Claims.

SURVEY & REMONUMENTATION

MAR 28 2000

SECTION

Register of Deeds Stamp & File Number

Section grid table with columns A-M and rows 1-13. A dot is marked at the intersection of column E and row 5.

I, Joseph C. Domitrovich, in a field survey on August 22, 1999, do hereby state that under requirements of P.A. 74, Michigan P.A. of 1970, the corner points mentioned in lines 1 and 2 above were in conformance with regulations and rules therefore as required in the current manual of survey instructions of the United States Department of the Interior, Bureau of Land Management or by a decree of a Court of Law and for that the corner points mentioned in lines 3, 4 and 5 above were in conformance with the rules of the Michigan Board of Land Surveyors or by a Decree of a Court of Law; established, re-established, monumented, recovered, found as expressed below:

NOTE: Not more than 2 corners, all in the same town and range, may be recorded on this certificate.

A. Description of original monument and accessories and/or subsequent restoration:

(E-5) Section Corner Common to Sections 8, 9, 16 and 17, T51N, R39W.

- 1845 - Austin Burt set an Ironwood Post
12" Hemlock S 46° E 49 links
16" Hemlock N 18° W 6 links

B. Description of corner evidence found and/or method applied in restoring or reestablishing corner:

I found no remains of the original corner or accessories. At the 1/4 corner position I found a North - South Paved road (Woodspur Road) running along the section line but no other evidence of corner position. I reestablished latitude of the corner position by proportionate measurement between the East 1/4 corner of Section 17 (1/2 mile south) and the Northeast Corner of Section 8 (one mile North). I used the existing centerline of Woodspur road to establish the departure of the corner position. Distances to corners North, South and West work well with GLO distances.


Research on file with County Remonumentation Representative.

C. Description of monument for corner and accessories established to perpetuate locating the position of the corner:

Corner is a 5/8" iron pin with a 3" diameter brass cap stamped to read: COUNTY REMONUMENTATION; T.51N, R.39W; S.8, S.9, S.17, S.16; 1999; P.S. 37273. Corner falls on centerline of Woodspur Road. I also established a Reference Monument (R.M.) to the east; a 3/4" x 48" aluminum rod with a 3" diameter aluminum cap stamped to indicate that the 1/4 corner is N 89°50'W 31.71'.

Ties:

Table listing ties: Power Pole, R.M., 9" Soft Maple, 7" Basswood, 1/2" Iron # 37273, E 1/4 Corner of Sec. 8, E 1/4 Corner of Sec. 17, N 1/4 Corner of Sec. 17 with bearings and distances.

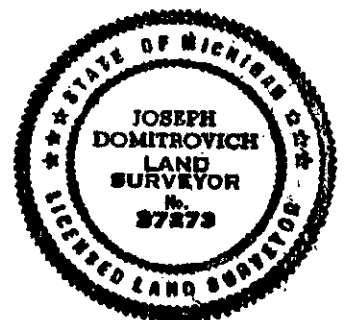

NOTE: Bearings to witness objects are magnetic. Distances are to a nail in side of the witness object unless noted.

BEFORE OUR APPROVAL

Signature of Paul W. Applbaum, County Remonumentation Representative, dated 8-24-99.

Signed by J. C. Domitrovich

Date 8/24/99

Surveyor's Michigan License No. 37273