

JUDITH D. ROEHN

IP

LAND CORNER RECORDATION CERTIFICATE

Filing Requirement of Act 74, Mich. P.A. of 1970

Ontonagon County Remonumentation Corner

Ontonagon County

Page 1 of 1

LC

5/212

REC. Date 07/27/99 Time 15:00

RECORDING FEE: 9.00

For corners in

Ontonagon County	Located in:	Corner Code #
1. Public Land Survey	T51N R39W	E - 7
	T R	
	T R	
	T R	
2. Property Controlling in Section	S T R	
	S T R	
3. Miscellaneous Property in Sec.	S T R	
	S T R	
4. Lot No. , Recorded Plat		
5. Private Claims		

SURVEY & REMONUMENTATION

MAR 23 2000

SECTION

Register of Deeds Stamp & File Number

	A	B	C	D	E	F	G	H	I	J	K	L	M
1													
2	6		5		4		3		2		1		
3													
4	7		8		9		10		11		12		
5													
6	18		17		16		15		14		13		
7													
8	19		20		21		22		23		24		
9													
10	30		29		28		27		26		25		
11													
12	31		32		33		34		35		36		
13													

I, Joseph C. Domitrovich, in a field survey on July 16, 1999, do hereby state that under requirements of P.A. 74, Michigan P.A. of 1970, the corner points mentioned in lines 1 and 2 above were in conformance with regulations and rules therefore as required in the current manual of survey instructions of the United States Department of the Interior, Bureau of Land Management or by a decree of a Court of Law and for that the corner points mentioned in lines 3, 4 and 5 above were in conformance with the rules of the Michigan Board of Land Surveyors or by a Decree of a Court of Law; established, re-established, monumented, recovered, found as expressed below:

NOTE: Not more than 2 corners, all in the same town and range, may be recorded on this certificate.

A. Description of original monument and accessories and/or subsequent restoration:

(E-7) Corner Common to Sections 16, 17, 20 and 21, T51N, R39W.

1845 - Austin Burt set a sugar post:

12" Hemlock	S22°W	48 links
8" Sugar	N72°E	32 links

1949 - U.S. Highway 45 construction plans show 3/4" iron pin at this corner and distances to Section Corners east and west. The plans indicate that it is 5.22' East of Centerline.

1989 - Brian Taavola P.S. 21583 recorded this corner in Liber 3, page 101 of corner records. He found a P.K. Nail and 3 witnesses by an unknown person. He replaced it with a P.K. Nail and brass cap stamped: "Section Corner," It fell 5' East of centerline. He gave 4 witnesses:

13" Elm	S60°W	118.59'
Power Pole	S10°W	113.93'
Face of Project Marker	S75°E	94.10'
Power Pole	N50°E	58.15'

PEER GROUP APPROVED  
Paul W. Applekamp 7-20-99  
COUNTY REGISTER

B. Description of corner evidence found and/or method applied in restoring or reestablishing corner:


I found no remains of the original corner or accessories. Corner now falls at the Intersection of: U.S. Highway 45 to the NW and SE, Mountain View road to the West, a two track trail to the East and Woodspur road to the North. I recovered the P.K. Nail and stamped brass washer as called for by Brain Taavola. I recovered all of his witnesses. This corner works well with other corners to North, South, East and West. I accepted it as the section corner and added 2 reference monuments.

Research on file with County Remonumentation Representative.

C. Description of monument for corner and accessories established to perpetuate locating the position of the corner:

Corner is a P.K. Nail with a Brass Washer stamped "Section Corner." It falls 5' East of centerline U.S. Highway 45. I also established 2 reference monuments, 2 1/2" x 30" aluminum pipes with 3" diameter aluminum caps. The first (R.M. 1) is to the NorthEast and stamped to indicate that the Section Corner is S55°47'W, 64.70'. The second (R.M. 2) is to the Northwest and is stamped to indicate that the section corner is S72°47'E 94.36'. Ties:

Power Pole	N47°E	58.10'	(Existing Nail and Tag)
R.M. 1	N55°46'54"E	64.70'	
Face of Conc. Project Marker	S63°E	94.14'	(Existing)
Power Pole	S04°W	113.88'	(Existing Nail and Tag)
15" Elm	S54°W	118.40'	(New Nail)
R.M. 2	N72°47'01"W	94.36'	
NW Corner Sec. 20	N89°53'44"W	5289.52'	(5292.62' Hwy.)
NE Corner Sec. 21	N89°40'35"E	5269.81'	(5273.36' Hwy.)

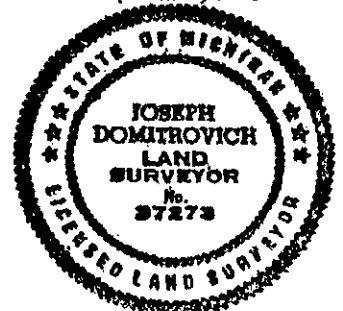

NOTE: Bearings to witness objects are magnetic. Distances are to a nail in side of the witness object unless noted.

Signed by Joseph C. Domitrovich

Date 7/20/99

Surveyor's Michigan License No. 37273