

DEC 16 1996

JUDITH D. ROEHN 05/09/96
Ontonagon County 10:40
LC 4/ 42 JEM Fee: 9.00
Page 1 of 1

COMMISSION LAND CORNER RECORDATION CERTIFICATE
Filing Requirement of Act 74, Mich. P.A. 1970

For corners in Ontonagon (County) Located In: Corner Code #
1. Public Land Survey T 51N R39W E-8
2. Property Controlling in Section S T R
3. Miscellaneous Property in Section S T R
4. Lot No. , Recorded Plat
5. Private Claims

Register of Deeds Stamp & File Number

Grid table with columns A-M and rows 2-13. A dot is marked at the intersection of column E and row 8.

I, Joseph C. Domitrovich, in a field survey on November 7, 1995, do hereby certify that under requirements of P.A. 74, Michigan P.A. of 1970, the corner points mentioned in lines 1 and 2 above were in conformance with regulations and rules therefore as required in the current manual of survey instructions of the United States Department of the Interior, Bureau of Land Management or by a decree of a Court of Law and/or that the corner points mentioned in lines 3, 4 and 5 above were in conformance with the rules of the Michigan Board of Professional Surveyors or by a Decree of a Court of Law; established, re-established, monumented, re-monumented, recovered, found as expressed below:

NOTE: Not more than 4 corners, all in the same town and range, may be recorded on this certificate.

A. Description of original monument and accessories and/or subsequent restoration:

(E-8) 1/4 corner common to sections 20 & 21, T51N R39W

1845 - Austin Burt for William A. Burt, set Ironwood post.

10" Sugar S 72° W 24 links

10" Sugar N 42° E 19 links

1947 - U.S. Highway 45 Highway R.O.W. plans on file at Ontonagon County Road Commission note section corners north and south of this 1/4 corner and the bearing and distance between them but do not indicate anything at the 1/4 corner.

B. Description of corner evidence found and/or method applied in restoring or reestablishing corner:

Found a 5/8" rerod at the intersection of old fences to the south and east. This position works well with section corners north and south. I accepted this position as the 1/4 corner and monumented it as such.

Research on file with County Remonumentation Representative.

C. Description of monument for corner and accessories established to perpetuate locating the position of the corner:


Corner is a 2" x 30" aluminum pipe with a 3" diameter aluminum cap stamped to read: T.51N., R.39W; 1/4 S.20, S.21; 1996; P.S. 37273. Corner falls at the intersection of fences to the south and east.

Witnesses:

- 5" Poplar N 30° E 28.35'
4" Ironwood N 80° E 12.24'
7" Ash S 05° E 16.70'
4" Hard Maple N 55° W 16.41'
6' Steel sign post North 0.89'

PEER GROUP APPROVED

Earl W. Applekamp
COUNTY REPRESENTATIVE

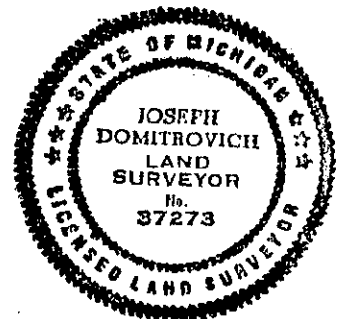

NOTE: Bearings are magnetic. Distances are to nail in side of witness objects unless noted.

Signed by J.C. Domitrovich Date 4/22/96

Surveyor's Michigan License No. 37273