

DEC 16 1996

COMMISSION

LAND CORNER RECORDATION CERTIFICATE  
Filing Requirement of Act 74, Mich. P.A. 1970

JUDITH D. ROEHM  
Ontonagon County  
4/39 JEM

05/09/96  
10:38  
Fee: 9.00  
Page 1 of 1

For corners in Ontonagon (County) Located In: Corner Code #

1. Public Land Survey T 51N R 39W E-9  
 T \_\_\_\_\_ R \_\_\_\_\_  
 T \_\_\_\_\_ R \_\_\_\_\_  
 T \_\_\_\_\_ R \_\_\_\_\_

2. Property Controlling S \_\_\_\_\_ T \_\_\_\_\_ R \_\_\_\_\_  
 in Section S \_\_\_\_\_ T \_\_\_\_\_ R \_\_\_\_\_

3. Miscellaneous S \_\_\_\_\_ T \_\_\_\_\_ R \_\_\_\_\_  
 Property in Section S \_\_\_\_\_ T \_\_\_\_\_ R \_\_\_\_\_

4. Lot No. \_\_\_\_\_, Recorded Plat \_\_\_\_\_

5. Private Claims \_\_\_\_\_

Register of Deeds Stamp & File Number

A	B	C	D	E	F	G	H	I	J	K	L	M
2	6	5	4	3	2							
3												
4	7	8	9	10	11	12						
5												
6	18	17	16	15	14	13						
7												
8	19	20	21	22	23	24						
9												
10	30	28	28	27	26	25						
11												
12	31	32	33	34	35	36						
13												

I, Joseph C. Domitrovich, in a field survey on November 7, 1995, do hereby certify that under requirements of P.A. 74, Michigan P.A. of 1970, the corner points mentioned in lines 1 and 2 above were in conformance with regulations and rules therefore as required in the current manual of survey instructions of the United States Department of the Interior, Bureau of Land Management or by a decree of a Court of Law and/or that the corner points mentioned in lines 3, 4 and 5 above were in conformance with the rules of the Michigan Board of Professional Surveyors or by a Decree of a Court of Law; established, re-established, monumented, re-monumented, recovered, found as expressed below:

NOTE: Not more than 4 corners, all in the same town and range, may be recorded on this certificate.

A. Description of original monument and accessories and/or subsequent restoration:

(E-9) Corner common to sections 20, 21, 28 & 29, T51N, R39W.

1845 - Austin Burt for William A. Burt, set sugar post  
16" Hemlock S 78° W 10 links  
14" Sugar N 29° E 34 links

1947 - U.S. Highway 45 R.O.W. plans show a bearing and distance of S 05° 39' 18" W, 5284.56' from the section corner to the north, to this corner. Also this corner is shown as being S 85° 15' 07" W, 3120.34' west of centerline of U.S. Highway 45.

1965 - M.S.H.D. R.O.W. plans for U.S. Highway 45 show the same distance west of centerline and also an angle of 59° 34' 07" off of tangent centerline. They call for corner as being a 1 1/2" iron pin and give 3 witnesses.

B. Description of corner evidence found and/or method applied in restoring or reestablishing corner:

Found all 3 M.S.H.D. witnesses and a 1 1/2" diameter iron pipe lying flat at the record bearings and distances from the witness objects. Also found a 1 1/4" diameter iron pipe 7 feet east of this position. The M.S.H.D. corner position worked well with record distances east and north. Accepted this position as the section corner and monumented it as such.

Research on file with County Remonumentation Representative.


C. Description of monument for corner and accessories established to perpetuate locating the position of the corner:

Corner is a 2" x 30" aluminum pipe with a 3" diameter aluminum cap stamped to read: T.51N., R.39W.; S.20, S.21, S.28, S.29; 1996; P.S. 37273. Corner falls in clearing for powerline.

Witnesses:

- Sawed off Power pole S 84° W 30.9' (M.S.H.D.)
- Power pole # 96 S 75° W 29.45'
- 6" Maple N 51° E 46.10' (M.S.H.D.)
- 11" Soft Maple N 82° E 40.25' (M.S.H.D.)
- 1 1/4" pipe N 87° E 7.13'
- 12" Yellow Birch S 09° W 72.10'
- 6' Steel sign post South 1.00'

PEER GROUP APPROVED  
Earl W. Applbaum  
COUNTY REPRESENTATIVE  
5-07-96

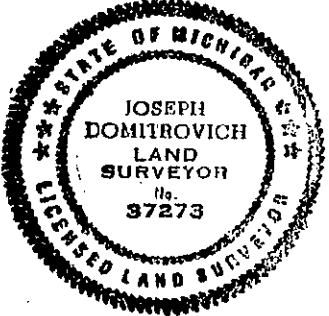

NOTE: Bearings are magnetic. Distances are to nail in side of witness objects unless noted.

Signed by Joseph C. Domitrovich

Date 4/22/96

Surveyor's Michigan License No. 37273