

LAND CORNER RECORDATION CERTIFICATE
Filing Requirement of Act 74, Mich. P.A. 1970

JIMMIE D. ROEHN
 Ontonagon County
 Page 1 of 1
 JEM Date 12/21/1999 Time 11:12:45
 RECORDING FEE: 9.00

For corners in

Ontonagon County	Located in:	Corner Code #
1. Public Land Survey	T51N R39W	F - 3
	T R	
	T R	
	T R	
2. Property Controlling in Section	S T R	
	S T R	
3. Miscellaneous Property in Sec.	S T R	
	S T R	
4. Lot No.	Recorded Plat	
5. Private Claims		

SURVEY & REMONUMENTATION

MAR 23 2000

SECTION

Register of Deeds Stamp & File Number

	A	B	C	D	E	F	G	H	I	J	K	L	M
1													
2	6	5	4	3	2	1							
3			●										
4	7	8	9	10	11	12							
5													
6	18	17	16	15	14	13							
7													
8	19	20	21	22	23	24							
9													
10	30	29	28	27	26	25							
11													
12	31	32	33	34	35	36							
13													

I, Joseph C. Domitrovich, in a field survey on December 2, 1999, do hereby state that under requirements of P.A. 74, Michigan P.A. of 1970, the corner points mentioned in lines 1 and 2 above were in conformance with regulations and rules therefore as required in the current manual of survey instructions of the United States Department of the Interior, Bureau of Land Management or by a decree of a Court of Law and for that the corner points mentioned in lines 3, 4 and 5 above were in conformance with the rules of the Michigan Board of Land Surveyors or by a Decree of a Court of Law; established, re-established, monumented, recovered, found as expressed below:

NOTE: Not more than 2 corners, all in the same town and range, may be recorded on this certificate.

A. Description of original monument and accessories and/or subsequent restoration:

(F - 3) 1/4 Corner Common to Sections 4 & 9, T51N, R39W

1845 Auslin Burt set a Sugar Post with ties:

10" Hemlock	S 66°E	11 links
12" Sugar	N 69°W	18 links

1967 Mead Corporation Land Corner Records call for a 1 1/2" iron pipe at this corner.

B. Description of corner evidence found and/or method applied in restoring or reestablishing corner:

I found no remains of the original corner or accessories. I recovered the 1 1/2" iron pipe called for by Mead. There was a 1967 Copper Range location poster and 3 newer "Beaver" blazes facing the pipe. The pipe is now broken off and lying horizontal at the base of a blow-down. Distances from section corners to the pipe work well but it falls 42' off of a straight line between them. I did not accept the pipe. I re-established the 1/4 corner by single proportionate measurement. I believe this position best represents the location of the original 1/4 corner.


Research on file with County Remonumentation Representative.

PEER GROUP APPROVAL
Paul W. Applekamp
 COUNTY Surveyor
 12-20-99

C. Description of monument for corner and accessories established to perpetuate locating the position of the corner:

Corner is a 3/4" x 72" aluminum rod with a 3" diameter aluminum cap stamped to read: COUNTY REMONUMENTATION; T51N, R39W; S. 4, S. 9; 1/4; 1999; P.S. 37273. Ties:

7" Hard Maple	North	2.81' (existing blazes of 4 sides)
Twin 9" Hard Maples	N 58°W	32.25'
4" Hard Maple	S 54°W	18.01'
Steel Sign Rail	South	0.71' (to face)
7" Soft Maple	S 36° E	21.93'
Base of 1 1/2" pipe	S 02°24'E	42.8'
SW corner Section 4	S 89°39'54"W	2641.44'
SE Corner Section 4	N 89°39'54"E	2641.44'

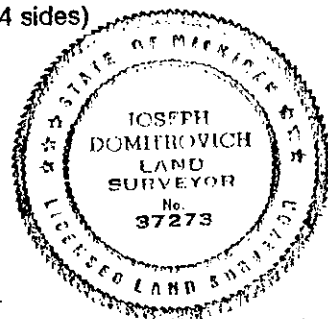

NOTE: Bearings to witness objects are magnetic. Distances are to a nail in side of the witness object unless noted.

Signed by Joseph C. Domitrovich

Date 12/14/99

Surveyor's Michigan License No. 37273