

JUDITH D. ROEHN

IF

LAND CORNER RECORDATION CERTIFICATE  
Filing Requirement of Act 74, Mich. P.A. 1970

Ontonagon County

Page 1 of 1

LC 5/264

REC'D Date 12/21/1999

Time 11:12:45

RECORDING FEE:

9.00

For corners in

Ontonagon County	Located in:	Corner Code #
1. Public Land Survey	T51N R39W	G - 2
	T R	
	T R	
	T R	
2. Property Controlling in Section	S T R	
	S T R	
3. Miscellaneous Property in Sec.	S T R	
	S T R	
4. Lot No. , Recorded Plat		
5. Private Claims		

SURVEY & REMONUMENTATION

MAR 23 2000

SECTION

Register of Deeds Stamp & File Number

	A	B	C	D	E	F	G	H	I	J	K	L	M
1													
2	6		5		4		3		2		1		
3													
4	7		8		9		10		11		12		
5													
6	18		17		16		15		14		13		
7													
8	19		20		21		22		23		24		
9													
10	30		29		28		27		26		25		
11													
12	31		32		33		34		35		36		
13													

I, Joseph C. Domitrovich, in a field survey on December 6, 1999, do hereby state that under requirements of P.A. 74, Michigan P.A. of 1970, the corner points mentioned in lines 1 and 2 above were in conformance with regulations and rules therefore as required in the current manual of survey instructions of the United States Department of the Interior, Bureau of Land Management or by a decree of a Court of Law and for that the corner points mentioned in lines 3, 4 and 5 above were in conformance with the rules of the Michigan Board of Land Surveyors or by a Decree of a Court of Law; established, re-established, monumented, recovered, found as expressed below:

NOTE: Not more than 2 corners, all in the same town and range, may be recorded on this certificate.

A. Description of original monument and accessories and/or subsequent restoration:

(G - 2) 1/4 Corner Common to Sections 3 & 4, T51N, R39W

1845 Austin Burt set corner in a stream with ties:

8" Elm	S 30°E	27 links
10" B. Ash	N 32°W	29 links

1966 C.C. Lindgren P.S. 14098 (for Michigan State Highway Department) found a 1" iron pipe at a fence corner in creek. He gave a distance South to the Section Corner. Ties:

12" Elm	S 50°W	15.15'
10" Elm	N 15°W	10.11'
8" Basswood	East	12.40'

B. Description of corner evidence found and/or method applied in restoring or reestablishing corner:

I found no remains of the original corner or bearing trees. I recovered the 1" iron pipe called for by Lindgren but all of his bearing trees are now gone. The pipe falls on the extension of a fenceline to the South and West. Distances from this pipe to GLO stream crossings North and South work very well. Distances to Sections corners North and South work well with GLO. Distance South to Sections corner also works well with Lindgren's distance. I accepted the pipe as the 1/4 corner.

Research on file with County Remonumentation Representative.


DEED GROUP APPROVAL

*Earl W. [Signature]*  
COUNTY REMONUMENTATION

C. Description of monument for corner and accessories established to perpetuate locating the position of the corner: 12-20-99

Corner is a 1/4" x 48" aluminum rod driven into the recovered 1" pipe. The corner is underwater in a stream-bed. I placed a 3" diameter aluminum cap on the rod and stamped it to read: COUNTY REMONUMENTATION; T51N, R39W; 1/4; S. 4, S.3; 1999; P.S. 37273. Ties:

NE Corner Sec. 4	N 00°32'07"W	2615.78' meas. (2607' GLO)
SE Corner Sec. 4	S 01°00'13"E	2638.44' meas. (2640' GLO) 2640.45' (M.S.H.D.)
Westerly of twin 16" S. Maples	N 33°E	38.62'
14" Soft Maple	S 10°W	24.33'
Steel sign rail	N 78°W	7.37' (to face)
20" Soft Maple	N 54°W	6.26'

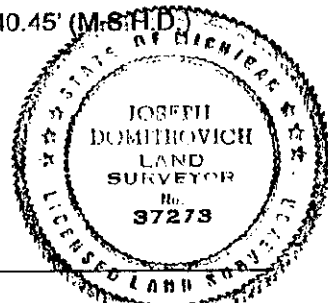

NOTE: Bearings to witness objects are magnetic. Distances are to a nail in side of the witness object unless noted.

Signed by *J.C. Domitrovich*

Date 12/14/99

Surveyor's Michigan License No. 37273