

LAND CORNER RECORDATION CERTIFICATE
 Filing Requirement of Act 74, Mich. P.A. 1970

For corners in

Ontonagon
 (County)

Located In:	Corner Code #
T 51NR 39W	G-8
T R	
T R	
T R	
S T R	
S T R	
S T R	
S T R	

**SURVEY &
 REMONUMENTATION**

APR 07 1998

SECTION


Register of Deeds Stamp & File Number

1. Public Land Survey

2. Property Controlling
 in Section

3. Miscellaneous
 Property in Sec.

4. Lot No. _____, Recorded Plat _____
 5. Private Claims _____

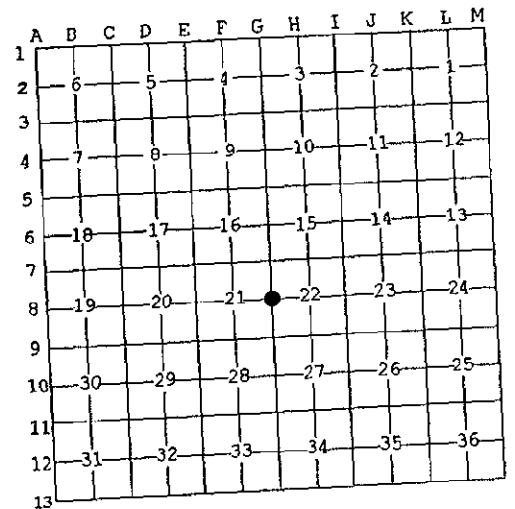

I, Joseph C. Domitrovich, in a field survey on September 9, 1997 do hereby state that under requirements of P.A. 74, Michigan P.A. of 1970, the corner points mentioned in lines 1 and 2 above were in conformance with regulations and rules therefore as required in the current manual of survey instructions of the United States Department of the Interior, Bureau of Land Management or by a decree of a Court of Law and/or that the corner points mentioned in lines 3, 4 and 5 above were in conformance with the rules of the Michigan Board of Land Surveyors or by a Decree of a Court of Law, established, re-established, monumented, recovered, found as expressed below:

NOTE: Not more than 2 corners, all in the same town and range, may be recorded on this certificate.

(G-8) 1/4 Corner Common to Sections 21 & 22, T51N, R39W

A. Description of original monument and accessories and/or subsequent restoration:

1845 - Austin Burt set black ash post
 12" Black Ash S 78° W 13 links
 10" Elm N 43° E 14 links

B. Description of corner evidence found and/or method applied in restoring or reestablishing corner:

Original corner and accessories have been destroyed by clearcutting and beaver flooding. I have re-established the corner by single proportionate measurement. This works well with an old East-West logging road and fallen North-South fence.

PEER GROUP APPROVAL
Earl W. Applkamp
 COUNTY _____ 12-01-97

Research on file with County Remonumentation Representative.

C. Description of monument for corner and accessories established to perpetuate locating the position of the corner:
 Corner is a 5/8" x 48" rebar, set in approximate centerline of old East-West logging road, with a 3" diameter aluminum cap stamped to read: COUNTY REMONUMENTATION; 1/4; S. 21, S. 22; T. 51N, R. 39W; 1997; P.S. 37273.

Witnesses:

9" Soft Maple	N 45° E	37.71'
Steel Sign Post	South	9.27' (to face)
Steel Sign Post	N 45° W	18.70' (to face)
3" Soft Maple	N 22° E	22.46'
NE Cor. Section 21	N 02° 02' 10" E	2629.28'
SE Cor. Section 21	S 02° 02' 10" W	2629.28'

NOTE: Bearings are magnetic. Distances are to nail in side of witness objects unless noted.

Signed by J. C. Domitrovich
 Surveyor's Michigan License No. 37273

Date 11/25/97

