

**SURVEY & REMONUMENTATION**

DEC 16 1996

COMMISSION

JUDITH D. ROEHM  
Ontonagon County

05/09/96  
10:41

**LAND CORNER RECORDATION CERTIFICATE**


4/ 45 JEM Fee: 9.00  
Page 1 of 1

Filing Requirement of Act 74, Mich. P.A. 1970

For corners in Ontonagon (County)	Located In:	Corner Code #
1. Public Land Survey	T 51N R 39W	I-3
	T _____ R _____	_____
	T _____ R _____	_____
	T _____ R _____	_____
2. Property Controlling in Section	S _____ T _____ R _____	_____
	S _____ T _____ R _____	_____
3. Miscellaneous Property in Section	S _____ T _____ R _____	_____
	S _____ T _____ R _____	_____

Register of Deeds Stamp & File Number

4. Lot No. \_\_\_\_\_, Recorded Plat \_\_\_\_\_  
5. Private Claims \_\_\_\_\_

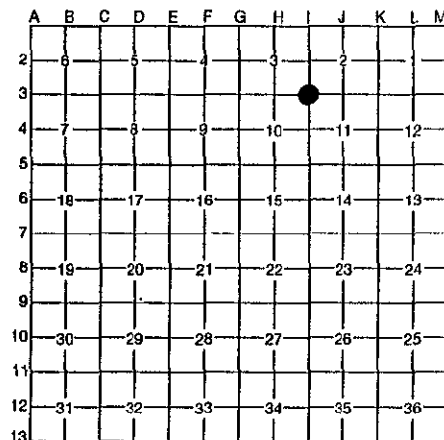

I, Joseph C. Domitrovich, in a field survey on May 26, 19 95, do hereby certify that under requirements of P.A. 74, Michigan P.A. of 1970, the corner points mentioned in lines 1 and 2 above were in conformance with regulations and rules therefore as required in the current manual of survey instructions of the United States Department of the Interior, Bureau of Land Management or by a decree of a Court of Law and/or that the corner points mentioned in lines 3, 4 and 5 above were in conformance with the rules of the Michigan Board of Professional Surveyors or by a Decree of a Court of Law; established, re-established, monumented, re-monumented, recovered, found as expressed below:

**NOTE: Not more than 4 corners, all in the same town and range, may be recorded on this certificate.**

**A. Description of original monument and accessories and/or subsequent restoration:**

Corner of Sections 2, 3, 10, and 11 T51N, R39W

1845 - Austin Burt for William A. Burt, set Ironwood post

16" Sugar S 30° W 37 links

7" Sugar N 37° E 20 links

1966 - C.C. Lingren P.S. 14098, M.S.H.D. for M-38 highway plans show corner as a 3/4" drillrod and established three new bearing trees.. Also an angle and distance off of centerline M-38 to this corner is shown on plans.

**B. Description of corner evidence found and/or method applied in restoring or reestablishing corner:**

No original evidence remains due to clearing for farmland.

Found the 3/4" drillrod (Actually a 3/4" lightning rod.) as called for by Lingren and the rotted remains of 2 of his bearing trees. The rod fell at the intersection of very old fences to west, north and south. Corner also matches angle and distance off of centerline M-38.

Accepted this position as the section corner and monumented it as such.

Research on file with County Remonumentation Representative.

**C. Description of monument for corner and accessories established to perpetuate locating the position of the corner:**

Corner is a 2" x 30" aluminum pipe with a 3" diameter aluminum cap stamped to read: T.51N., R.39W.; S.3, S.2, S.10, S.11; 1996; P.S. 37273. Corner falls at a fence intersection 26.5' west of centerline of a north-south field road.


Witnesses:

3' Balsam	South	22.83'
4" Soft Maple	S 36° W	10.32'
5" Spruce	N 60° W	8.36'
7" Soft Maple	N 27° W	24.90'
Steel Sign Post	North	0.90'

PEER GROUP APPROVED

*Earl W. Applebaum*  
COUNTY REPRESENTATIVE

05-07-96

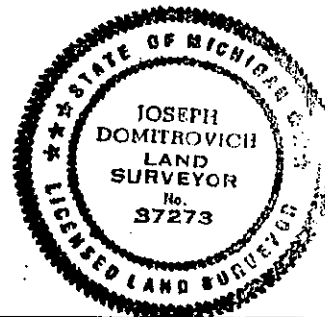

**NOTE: Bearings are magnetic. Distances are to nail in side of witness objects unless noted.**

Signed by Joseph C. Domitrovich

Date 5/6/96

Surveyor's Michigan License No. 37273