

DEC 1 8 1996

COMMISSION

JUDITH D. ROEHM
 Ontonagon County
 LC 4/ 44 JEM Fee: 9.00
 Page 1 of 1

LAND CORNER RECORDATION CERTIFICATE
Filing Requirement of Act 74, Mich. P.A. 1970

For corners in <u>Ontonagon</u> <small>(County)</small>	Located In:	Corner Code #
1. Public Land Survey	T <u>51N</u> R <u>39W</u>	<u>I-5</u>
	T _____ R _____	_____
	T _____ R _____	_____
	T _____ R _____	_____
2. Property Controlling in Section	S _____ T _____ R _____	_____
	S _____ T _____ R _____	_____
3. Miscellaneous Property in Section	S _____ T _____ R _____	_____
	S _____ T _____ R _____	_____

Register of Deeds Stamp & File Number

4. Lot No. _____, Recorded Plat _____
 5. Private Claims _____

A	B	C	D	E	F	G	H	I	J	K	L	I
2	6	5	4	3	2	1						
3												
4	7	8	9	10	11	12						
5												
6	18	17	16	15	14	13						
7												
8	19	20	21	22	23	24						
9												
10	30	29	28	27	26	25						
11												
12	31	32	33	34	35	36						
13												

I, Joseph C. Domitrovich, in a field survey on May 26, 19 95, do hereby certify that under requirements of P.A. 74, Michigan P.A. of 1970, the corner points mentioned in lines 1 and 2 above were in conformance with regulations and rules therefore as required in the current manual of survey instructions of the United States Department of the Interior, Bureau of Land Management or by a decree of a Court of Law and/or that the corner points mentioned in lines 3, 4 and 5 above were in conformance with the rules of the Michigan Board of Professional Surveyors or by a Decree of a Court of Law; established, re-established, monumented, re-monumented, recovered, found as expressed below:

NOTE: Not more than 4 corners, all in the same town and range, may be recorded on this certificate.

A. Description of original monument and accessories and/or subsequent restoration:

(I-5) Corner of Sections 10, 11, 14, and 15, T51N, R39W

1845 - Austin Burt for William A. Burt, set Birch Post

22" Hemlock S 30° W 29 links

8" Sugar [] 68° E 17 links

1966 - C.C. Lingren P.S. 14098, M.S.H.D. for M-38 Highway plans show corner as a 1" angle iron 3' high and established 3 new bearing trees. Also an angle and distance off of centerline M-38 to this corner is shown.

B. Description of corner evidence found and/or method applied in restoring or reestablishing corner:

All original evidence has been obliterated by extensive clearcutting and bulldozing. Found the base of a bent angle iron matching Lingren's description and two of his remaining bearing trees. This position worked well with angle and distance off of centerline M-38.

PEER GROUP APPROVED

Earl W. Applekamp 05-07-96
 COUNTY REPRESENTATIVE


Research on file with County Remonumentation Representative.

C. Description of monument for corner and accessories established to perpetuate locating the position of the corner:

Corner is a 2" x 30" aluminum pipe with a 3" diameter aluminum cap stamped to read: T.51N., R.39W.; S.10, S.11, S.14, S.15; 1996; P.S. 37273. Corner falls 12' northwest of an old railroad grade (Now a bulldozed logging road) on a curve.

Witnesses:

8" Twin Ash	S 40° W	13.12 (M.S.H.D.)
13" Soft Maple	S 87° W	11.94'
8" Hard Maple in clump	N 50° W	36.17'
12" Triple Hard Maple	N 10° W	26.65' (M.S.H.D.)
Steel Sign Post	South	0.64'

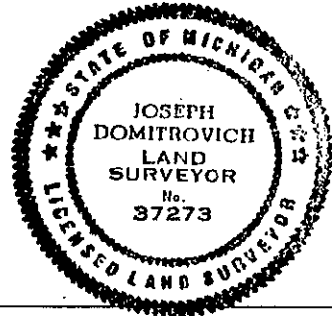

NOTE: Bearings are magnetic. Distances are to nail in side of witness objects unless noted.

Signed by Joseph C. Domitrovich

Date 5/6/96

Surveyor's Michigan License No. 37273