

LAND CORNER RECORDATION CERTIFICATE
Filing Requirement of Act 74, Mich. P.A. 1970
Ontonagon County Remonumentation Corner

Page 1 of 1
LC 5/172
JEN. Rec. Date 12/29/98 Time 16:18
RECORDING FEE: 9.00

For corners in

Table with columns: Ontonagon County, Located in, Corner Code #. Rows include Public Land Survey, Property Controlling in Section, Miscellaneous Property in Sec., Lot No., and Private Claims.

SURVEY & REMONUMENTATION

MAR 10 1999

SECTION

I, Joseph C. Domitrovich, in a field survey on December 7, 1998, do hereby state that under requirements of P.A. 74, Michigan P.A. of 1970, the corner points mentioned in lines 1 and 2 above were in conformance with regulations and rules therefore as required in the current manual of survey instructions of the United States Department of the Interior, Bureau of Land Management or by a decree of a Court of Law and for that the corner points mentioned in lines 3, 4 and 5 above were in conformance with the rules of the Michigan Board of Land Surveyors or by a Decree of a Court of Law; established, re-established, monumented, recovered, found as expressed below:

NOTE: Not more than 2 corners, all in the same town and range, may be recorded on this certificate.

A. Description of original monument and accessories and/or subsequent restoration: (I-11) - Corner Common to Sections 26, 27, 34 & 35, T51N, R39W

1845 - Austin Burt set corner

12" Lynn S 73° W 26 links
10" Sugar N 65° E 26 links

1951 - Mead Corporation records indicate that the corner was a 1" iron pipe with a Cedar stake.

4" Ash with yellow tag S 35° W 18 links (11.88')
5" Ash with names on it S 18° E 9 links (5.94')
7" Red Maple w/ W.A.W. mark on it N 03° W 29 1/2 links (19.47')

PEER GROUP APPROVED
Earl W Applekamp
COUNTY REGISTER
12-18-98

B. Description of corner evidence found and/or method applied in restoring or reestablishing corner:

I found the rotted remains of both original bearing trees, now 20"+ diameter mounds. I also recovered the iron pipe called for by Mead at the correct bearings and distances from these mounds. I recovered all three of the Mead bearing trees. The yellow forest service location poster is still visible and has the initials W.A.W and the year 1951 written on it (William A. Waara). The iron pipe falls on the extension of old fencelines to the South and West. It also works well with other corners in this township. I have accepted the iron pipe as the Section Corner.


Research on file with County Remonumentation Representative.

C. Description of monument for corner and accessories established to perpetuate locating the position of the corner:

Corner is a 1 1/2" O.D. iron pipe with a 5/8" x 48" iron pin driven into it with a 3" diameter aluminum cap stamped to read: County Remonumentation; T.51N., R.39W.; S.26,S.27, S.34, S.35; 1998; P.S. 37273.

Witnesses:

Table listing witness objects: 12" Soft Maple, 4" Soft Maple, 11" Ash, Steel Sign rail, 8" Ash, 7" Soft Maple, N1/4 Corner Sec. 35, W1/4 Corner Sec. 35 with bearings and distances.

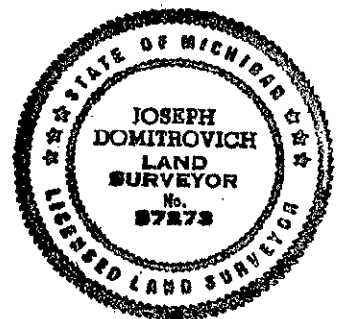

NOTE: Bearings to witness objects are magnetic. Distances are to a nail in side of the witness object unless noted.

Signed by [Signature]

Date 12-18-98

Surveyor's Michigan License No. 37273