

JUDITH D. ROEHM
Ontonagon County

1P
5/173
Time 16:19
9.00

LAND CORNER RECORDATION CERTIFICATE
Filing Requirement of Act 74, Mich. P.A. of 1970
Ontonagon County Remonumentation Corner

For corners in

Ontonagon County

Located in:

Corner Code #

1. Public Land Survey

T51N R39W I-12

T
T
T
T
T
T

R
R
R
R
R
R

SURVEY &
REMONUMENTATION

MAR 10 1999

2. Property Controlling
in Section

S
S
S
S

3. Miscellaneous
Property in Sec.

4. Lot No.

, Recorded Plat

5. Private Claims

Register of Deeds Stamp & File Number

SECTION

	A	B	C	D	E	F	G	H	I	J	K	L	M
1													
2	6		5		4		3		2		1		
3													
4	7		8		9		10		11		12		
5													
6	18		17		16		15		14		13		
7													
8	19		20		21		22		23		24		
9													
10	30		29		28		27		26		25		
11													
12	31		32		33		34		35		36		
13													

I, Joseph C. Domitrovich, in a field survey on November 24, 1998, do hereby state that under requirements of P.A. 74, Michigan P.A. of 1970, the corner points mentioned in lines 1 and 2 above were in conformance with regulations and rules therefore as required in the current manual of survey instructions of the United States Department of the Interior, Bureau of Land Management or by a decree of a Court of Law and for that the corner points mentioned in lines 3, 4 and 5 above were in conformance with the rules of the Michigan Board of Land Surveyors or by a Decree of a Court of Law; established, re-established, monumented, recovered, found as expressed below:

NOTE: Not more than 2 corners, all in the same town and range, may be recorded on this certificate.

A. Description of original monument and accessories and/or subsequent restoration:
(I-12) 1/4 Corner Common to Sections 34 and 35, T51N, R39W

1845 - Austin Burt set a Sugar Post

16" Hemlock S 27°E 35 links

18" Hemlock N 38°W 30 links

1947 - Michigan State Highway Dept. on US 45 Highway plans show a 1/4 corner here that is 2595.97' North of the SW corner of Section 35.

1984 - Mead corporation records indicate that the corner was a 3/4" iron pipe with 3 witness trees on the edge of an old road.

B. Description of corner evidence found and/or method applied in restoring or reestablishing corner:

I recovered the M.S.H.D. corner which is a 1" iron pipe with a pinched top. It falls 2595.04' north of the SW Corner of Section 35. I also found a 3/4" iron pipe and three Hemlocks with painted "beavers" facing it, as called for by Mead. It was N 24°E 29.70' from the M.S.H.D. pipe. I recovered the rotted remains of both original Hemlock bearing trees, now rotten mounds with Hemlock bark and knots. Original bearings and distances from these mounds work well with a position created by single proportionate measurement between Section Corners. This created position also works well with an old fallen fence to the North and a fence grown into trees to the East. I monumented the single proportionate position as the 1/4 Corner.

Research on file with County Remonumentation Representative.

C. Description of monument for corner and accessories established to perpetuate locating the position of the corner:


Corner is a 5/8" x 48" iron pin with a 3" diameter cap stamped to read: COUNTY REMONUMENTATION; T.51N., R.39W.; 1/4; S.34, S.35; 1998; P.S. 37273. Corner falls 120' North of centerline of highway US 45.

Witnesses:

5" Ironwood	N 58°E	11.48'	
3/4" Iron Pipe	S 47°52'E	19.34'	(Mead Corner)
16" Hemlock	S 26°E	14.37'	
1" Pinched Top Pipe	S 03°03'E	40.11'	(M.S.H.D. Corner)
8" Hemlock	S 30°W	13.76'	
Steel Sign Rail	North	0.66'	(to face)
NW Cor. Sec. 35	N 00°11'25"W	2835.19'	
SW Cor. Sec. 35	S 00°11'25"E	2635.19'	

PEER GROUP APPROVED

Paul W. Applikamp
COUNTY REPRESENTATIVE
12-18-98

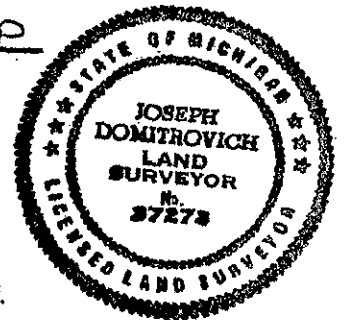

NOTE: Bearings to witness objects are magnetic. Distances are to a nail in side of the witness object unless noted.

Signed by *Joseph C. Domitrovich*

Date 12-18-98

Surveyor's Michigan License No. 37273