

LAND CORNER RECORDATION CERTIFICATE
Filing Requirement of Act 74, Mich. P.A. of 1970
Ontonagon County Remonumentation Corner

Ontonagon County LC 5/174
Time Rec. Date 12/29/98 Time 16:19
RECORDING FEE: 9.00

For corners in

- Ontonagon County Located in: Corner Code #
1. Public Land Survey T51N R39W J-11
2. Property Controlling in Section S T R
3. Miscellaneous Property in Sec. S T R
4. Lot No. , Recorded Plat
5. Private Claims

SURVEY &
REMONUMENTATION

MAR 10 1999

SECTION

Register of Deeds Stamp & File Number

Grid table with columns A-M and rows 1-13. A dot is present at the intersection of row 11 and column J.

I, Joseph C. Domitrovich, in a field survey on December 7, 1998, do hereby state that under requirements of P.A. 74, Michigan P.A. of 1970, the corner points mentioned in lines 1 and 2 above were in conformance with regulations and rules therefore as required in the current manual of survey instructions of the United States Department of the Interior, Bureau of Land Management or by a decree of a Court of Law and for that the corner points mentioned in lines 3, 4 and 5 above were in conformance with the rules of the Michigan Board of Land Surveyors or by a Decree of a Court of Law; established, re-established, monumented, recovered, found as expressed below:

NOTE: Not more than 2 corners, all in the same town and range, may be recorded on this certificate.

A. Description of original monument and accessories and/or subsequent restoration:
(J-11) - 1/4 Corner Common to section 26 and 35, T51N, R39W

- 1845 - Austin Burt set a birch post
18" Hemlock S52°W 43 links
8" Sugar N31°E 37 links

1980 - Mead Corporation records indicate that there was an iron pipe at this corner.

B. Description of corner evidence found and/or method applied in restoring or reestablishing corner:

I found no remains of the original corner or accessories. The area Southwest of the corner is now a cleared field. I found a 1 1/2" iron pipe at the intersection of the extension of old fencelines to the West, East and South. Distances to Section Corners to the East and West are considerably shorter and longer than G.L.O. I spoke with Mr. Francis Dahl, a lifelong resident of the area. He told me that his father began farming the area south of this Corner in 1915. His father put up the fences in the 1920's, at the same time that a county road was built along the West 1/16 line of this section. He stated that the fence intersection at the corner of his field has always been the accepted position of the 1/4 Corner. To put the corner at a split of the distances between corners would put it over 35 feet into the field and would disrupt the 1/16 fences and the road built along 1/16 lines.

Because of longtime usage and acceptance, I have accepted the pipe at the fence intersection as the 1/4 corner.

Research on file with County Remonumentation Representative.

C. Description of monument for corner and accessories established to perpetuate locating the position of the corner:


Corner is a 5/8" x 48" iron pin driven into the existing 1/4" iron pipe with a 3" diameter aluminum cap stamped to read: County Remonumentation; T.51N., R.39W.; 1/4; S.26, S.35; 1998; P.S. 37273.

Witnesses:

- 8" Poplar N70°E 6.11'
7" Poplar West 1.32'
4" Soft Maple N43°W 12.05'
Steel Sign Rail North 1.54' (to face)
NW Cor. Sec. 35 N89°47'15"W 2662.88'
NE Cor. Sec. 35 S89°47'35"E 2591.07'

PEER GROUP APPROVED

Earl W. Applekamp
COUNTY SURVEYOR
12-18-98

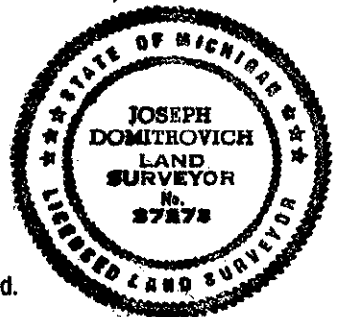

NOTE: Bearings to witness objects are magnetic. Distances are to a nail in side of the witness object unless noted.

Signed by [Signature]

Date 12-18-98

Surveyor's Michigan License No. 37273