

APR 29 1995

JUDITH D. ROEHM
Ontonagon County
LC 3/279 JEM

05/15/95
15:05
Fee: 9.00
Page 1 of 1

COMMISSION LAND CORNER RECORDATION CERTIFICATE
Filing Requirement of Act 74, Mich. P.A. 1970

For corners in

_____ (County)	Located In:	Corner Code #
1. Public Land Survey	T <u>51N</u> R <u>39W</u>	<u>K-7</u>
	T _____ R _____	_____
	T _____ R _____	_____
	T _____ R _____	_____
2. Property Controlling in Section	S _____ T _____ R _____	_____
	S _____ T _____ R _____	_____
3. Miscellaneous Property in Sec.	S _____ T _____ R _____	_____
	S _____ T _____ R _____	_____

Register of Deeds Stamp & File Number

- 4. Lot No. _____, Recorded Plat _____
- 5. Private Claims _____

Section corner common to Sections 13, 14, 23 and 24, T51N, R39W

I, John R. Garske, in a field survey on April 27, 19 95, do hereby certify that under requirements of P.A. 74, Michigan P.A. of 1970, the corner points mentioned in lines 1 and 2 above were in conformance with regulations and rules therefore as required in the current manual of survey instructions of the United States Department of the Interior, Bureau of Land Management or by a decree of a Court of Law and/or that the corner points mentioned in lines 3, 4 and 5 above were in conformance with the rules of the Michigan Board of Land Surveyors or by a Decree of a Court of Law; established, re-established, monumented, re-monumented, recovered, found as expressed below:

	A	B	C	D	E	F	G	H	I	J	K	L	M
2	6	5	4	3	2	1							
3													
4	7	8	9	10	11	12							
5													
6	18	17	16	15	14	13							
7													
8	19	20	21	22	23	24							
9													
10	30	29	28	27	26	25							
11													
12	31	32	33	34	35	36							
13													

NOTE: Not more than 4 corners, all in the same town and range, may be recorded on this certificate.

A. Description of original monument and accessories and/or subsequent restoration:

- September 1845 - Austin Burt set a sugar post, no bearing trees. 8.25 chains south - 12" hemlock line tree.
- Corner position shown on information from American Can Company.
- Corner shown on surveys for Stone Container by 1994 survey by Hitch Engineering.


B. Description of corner evidence found and/or method applied in restoring or reestablishing corner:

I found a 1" iron pipe at the corner position along with an old bearing tree tag on the ground. This corner position has been used and accepted for many years as old blaze lines run in cardinal directions from the pipe. Stone Container Corporation has used this as the corner and cleared accordingly. I am accepting the pipe as marking the true corner through general use and acceptance for many years. Any other position would not ly in harmony.

PEER GROUP APPROVED
Earl W. Applekamp
COUNTY _____

C. Description of monument for corner and accessories established to perpetuate locating the position of the corner:

I updated the corner position to state and county specifications by replacing the found 1" iron pipe with a 2 1/2" diameter x 30" long aluminum pipe with a 3 1/4" diameter aluminum cap stamped: County Remonumentation; T51N, R39W; 14, 13, 23, 24; 1995; R.L.S. 28410, from which I established the following bearing trees and reference object:
8" maple - N28°E - 19.41 feet
7" maple - S72°E - 15.24 feet
6" maple - S40°W - 13.93 feet
6' steel rail with sign - N45°W - 1.52 feet

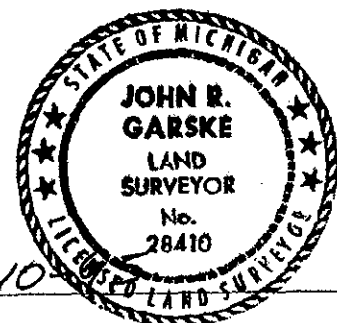

Signed by John R. Garske
Surveyor's Michigan License No. 28410

Date 5-10