

LAND CORNER RECORDATION CERTIFICATE
Filing Requirement of Act 74, Mich. P.A. 1970
Ontonagon County Remonumentation Corner

Page 1 of 1
LC 5/175
Rec. Date 12/29/98 Time 16:19
RECORDING FEE: 9.00

For corners in

- Ontonagon County Located in: Corner Code #
1. Public Land Survey T51N R39W K-11
2. Property Controlling in Section S S S T T T R R R R R R
3. Miscellaneous Property in Sec. S T R
4. Lot No. Recorded Plat
5. Private Claims

SURVEY & REMONUMENTATION

MAR 10 1999

SECTION

Register of Deeds Stamp & File Number

Grid table with columns A-M and rows 1-13. A dot is present in cell J11.

I, Joseph C. Domitrovich, in a field survey on December 8, 1998, do hereby state that under requirements of P.A. 74, Michigan P.A. of 1970, the corner points mentioned in lines 1 and 2 above were in conformance with regulations and rules therefore as required in the current manual of survey instructions of the United States Department of the Interior, Bureau of Land Management or by a decree of a Court of Law and/or that the corner points mentioned in lines 3, 4 and 5 above were in conformance with the rules of the Michigan Board of Land Surveyors or by a Decree of a Court of Law; established, re-established, monumented, recovered, found as expressed below:

NOTE: Not more than 2 corners, all in the same town and range, may be recorded on this certificate.

A. Description of original monument and accessories and/or subsequent restoration: (K-11) - Corner Common to Sections 25, 26, 35 and 36, T51N, R39W

- 1845 - Austin Burt set a Birch post
16" Hemlock S 28°W 50 links
40" Hemlock N 40°E 25 links

He intersected a small stream 1.90 chains North and 3.00 chains West of the corner.

1940 - Mead Corporation Records indicate a 1 1/2" iron pipe at the corner and a yellow tag on a 5' Red Maple, S66°E 11.0'

B. Description of corner evidence found and/or method applied in restoring or reestablishing corner:

I found no remains of the original corner or accessories. I found the iron pipe and bearing tree as called for by Mead. The yellow tag is a Forest Service location poster and has "W.A. Waara, 4-19-40" scratched on it and it indicates that the corner is N 66°W a distance of 11'. Distances North and West from this corner to stream beds are in agreement with GLO distances. The pipe also works well with other corners in the area. I have accepted it as the Section Corner.

Research on file with County Remonumentation Representative.

C. Description of monument for corner and accessories established to perpetuate locating the position of the corner:


Corner is a 3/4" x 48" aluminum rod driven into a 1 1/2" iron pipe with a 3" diameter aluminum cap stamped to read: COUNTY REMONUMENTATION; T.51N., R.39W.; S.25, S.26, S.35, S.36; 1998; P.S. 37273. Corner falls 18' South of an old logging road that runs Easterly-Westerly along the top of a ravine.

Witnesses:

- 6" Hard Maple S 40° W 13.25'
4" Yellow Birch N 80° W 12.54'
6" Balsam N 04° E 8.21'
13" Soft Maple (in clump) S 64° E 11.01' (Existing Forest Service Tag)
Steel sign post South 1.03' (To face)
N 1/4 Cor. Section 35 N 89°47'35" W 2591.07'
N 1/4 Cor. Section 36 N 89°40'14" E 2640.88'
W 1/4 Cor. Section 36 S 00°31'55" E 2812.93'

DEED GROUP APPROVAL
Earl W. Applekamp
COUNTY REMONUMENTATION

12-18-98

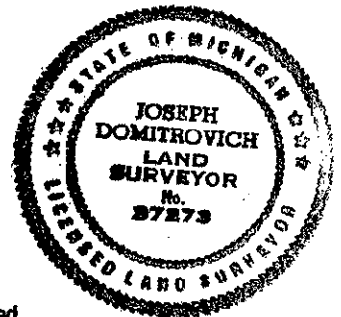

NOTE: Bearings to witness objects are magnetic. Distances are to a nail in side of the witness object unless noted.

Signed by [Signature]

Date 12-18-98

Surveyor's Michigan License No. 37273