

LAND CORNER RECORDATION CERTIFICATE
Filing Requirement of Act 74, Mich. P.A. 1970
Ontonagon County Remonumentation Corner

Ontonagon County

Page 1 of 1 LC 5/176
Rec. Date 12/29/98 Time 16:20
RECORDING FEE: 9.00

For corners in

- Ontonagon County Located in: Corner Code #
1. Public Land Survey T51N R39W K-12
2. Property Controlling in Section S T R
3. Miscellaneous Property in Sec. S T R
4. Lot No. , Recorded Plat
5. Private Claims SECTION

SURVEY & REMONUMENTATION

MAR 10 1999

Register of Deeds Stamp & File Number

Grid table with columns A-M and rows 1-13. A dot is present in cell J12.

I, Joseph C. Domitrovich, in a field survey on December 2, 1998, do hereby state that under requirements of P.A. 74, Michigan P.A. of 1970, the corner points mentioned in lines 1 and 2 above were in conformance with regulations and rules therefore as required in the current manual of survey instructions of the United States Department of the Interior, Bureau of Land Management or by a decree of a Court of Law and for that the corner points mentioned in lines 3, 4 and 5 above were in conformance with the rules of the Michigan Board of Land Surveyors or by a Decree of a Court of Law; established, re-established, monumented, recovered, found as expressed below:

NOTE: Not more than 2 corners, all in the same town and range, may be recorded on this certificate.

A. Description of original monument and accessories and/or subsequent restoration: (K-12) - 1/4 Corner Common to Sections 35 and 36, T51N, R39W

- 1845 - Austin Burt set a Sugar post
12" Hemlock S 25° E 13 links
16" Hemlock N 72° W 41 links

I found no subsequent Records.

B. Description of corner evidence found and/or method applied in restoring or reestablishing corner:

I found no remains of the original corner or accessories. At the corner position, I found an East-West Powerline along an old fence line and a gravel road to the South. The intersection of the Centerline of the gravel road (Dutch Road) and the Power/Fence line is the long used and accepted position of the 1/4 Corner. It falls within 5.19' North and 11.70' East of where the single proportionate position would be. I have accepted the intersection of the Pole Line and Centerline of Dutch Road as the 1/4 Corner position and have monumented it as such.

Research on file with County Remonumentation Representative.


C. Description of monument for corner and accessories established to perpetuate locating the position of the corner:

Corner is a 5/8" x 24" iron pin with a 3" diameter aluminum cap stamped to read: COUNTY REMONUMENTATION; T.51N, R.39W; 1/4 S.35, S.36; 1998; P.S. 37273. I also established a Reference Monument (R.M.) to the West, a 2 1/2" x 30" aluminum pipe with a 3" diameter aluminum cap stamped to indicate that the corner is East 21.44 feet.

Witnesses:

- Power Pole S 32° E 58.00'
12" Poplar S 25° W 141.10'
R.M. S 89°58'59" W 21.44'
24" Basswood N 77° W 32.01'
NW Cor. Section 36 N 00°31'55" W 2612.93'
SW Cor. Section 36 S 00°01'11" E 2623.30'

PEER GROUP APPROVED
Carl W. Applekamp
COUNTY REGISTER 12-18-98

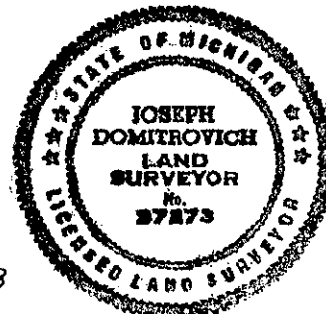

NOTE: Bearings to witness objects are magnetic. Distances are to a nail in side of the witness object unless noted.

Signed by J.C. Domitrovich

Date 12-18-98

Surveyor's Michigan License No. 37273