

MAY 05 1997

LAND CORNER RECORDATION CERTIFICATE
 Filing Requirement of Act 74, Mich. P.A. 1970

COMMISSION

For corners in Ontonagon Located In: _____ Corner Code # _____
 (County)

- | | | | | | | |
|--------------------------------------|---|------------|---|------------|-------------|-------|
| 1. Public Land Survey | T | <u>51N</u> | R | <u>39W</u> | <u>K-13</u> | |
| | T | _____ | R | _____ | _____ | |
| | T | _____ | R | _____ | _____ | |
| | T | _____ | R | _____ | _____ | |
| 2. Property Controlling in Section | S | _____ | T | _____ | R | _____ |
| | S | _____ | T | _____ | R | _____ |
| 3. Miscellaneous Property in Section | S | _____ | T | _____ | R | _____ |
| | S | _____ | T | _____ | R | _____ |

Register of Deeds Stamp & File Number

4. Lot No. _____, Recorded Plat _____
 5. Private Claims _____

A	B	C	D	E	F	G	H	I	J	K	L	M
2	6	5	4	3	2	1						
3												
4	7	8	9	10	11	12						
5												
6	18	17	16	15	14	13						
7												
8	19	20	21	22	23	24						
9												
10	30	29	28	27	26	25						
11												
12	31	32	33	34	35	36						
13												

I, Joseph C. Domitrovich, in a field survey on June 5, 1996, do hereby certify that under requirements of P.A. 74, Michigan P.A. of 1970, the corner points mentioned in lines 1 and 2 above were in conformance with regulations and rules therefore as required in the current manual of survey instructions of the United States Department of the Interior, Bureau of Land Management or by a decree of a Court of Law and/or that the corner points mentioned in lines 3, 4 and 5 above were in conformance with the rules of the Michigan Board of Professional Surveyors or by a Decree of a Court of Law; established, re-established, monumented, re-monumented, recovered, found as expressed below:

NOTE: Not more than 4 corners, all in the same town and range, may be recorded on this certificate.

A. Description of original monument and accessories and/or subsequent restoration:

(K-13) Standard Corner Sections 35 & 36, T51N, R39W

- 1845 - Austin Burt, set post
 10" Hemlock N 19° E 22 links
 32" Hemlock N 52° W 41 links

1947 - Highway U.S. 45 R.O.W. drawings on file at Ontonagon County Road Commission office show corner as being in centerline of county road but do not indicate what corner is.

B. Description of corner evidence found and/or method applied in restoring or reestablishing corner:

Found no remains of original GLO corner or accessories. At the corner position I found an east-west fence and a north-south gravel road. I re-established corner position at the intersection of the fence with the centerline of the county road. This position works well with standard and closing corners to the east.

Research on file with County Remonumentation Representative.


C. Description of monument for corner and accessories established to perpetuate locating the position of the corner:

Corner is a 5/8" x 24" rebar with a 3" diameter aluminum cap stamped to read: T.51N., R.39W.; S.35, S.36; S.C.; 1996 P.S. 37273. Corner falls in centerline of Dutch Road and on the extension of an old fence to west, old fence to east, and a line of 3' high red painted pipes to east. Also note a reference monument (R.M.) west of the road. R.M. is stamped to indicate that the corner is 23.40' to the east.

Witnesses:

- | | | |
|-----------------------|---------|--------|
| Power Pole | N 80° E | 31.50' |
| Red Pine | East | 32.91' |
| Triple 6" White Birch | S 51° W | 41.26' |
| R.M. | West | 23.40' |
| Steel Sign Post | West | 24.40' |
| 14" White Ash | N 51° W | 35.02' |

PEER GROUP APPROVED
Paul W. Applbaum
 COUNTY REPRESENTATIVE
 07-08-96

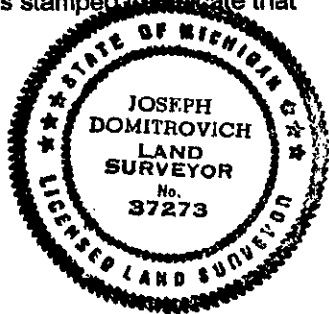

NOTE: Bearings are magnetic. Distances are to nail in side of witness objects unless noted.

Signed by Joseph C. Domitrovich Date 7/3/96

Surveyor's Michigan License No. 37273