

JUDITH D. ROEHM

1P

LAND CORNER RECORDATION CERTIFICATE
Filing Requirement of Act 74, Mich. P.A. 1970
Ontonagon County Remonumentation Corner

Ontonagon County
Page of 1 LC 5/179
JEM Rec. Date 12/29/98 Time 16:21
RECORDING FEE: 9.00

For corners in

- Ontonagon County Located in: Corner Code #
1. Public Land Survey T51N R39W M-12
T51N R38W A-12
2. Property Controlling S T R
in Section S T R
3. Miscellaneous S T R
Property in Sec. S T R
4. Lot No. Recorded Plat
5. Private Claims

SURVEY & REMONUMENTATION

MAR 10 1999

SECTION

Register of Deeds Stamp & File Number

Grid table with columns A-M and rows 1-13. Cell 12-36 contains a dot.

I, Joseph C. Domitrovich, in a field survey on December 2, 1998, do hereby state that under requirements of P.A. 74, Michigan P.A. of 1970, the corner points mentioned in lines 1 and 2 above were in conformance with regulations and rules therefore as required in the current manual of survey instructions of the United States Department of the Interior, Bureau of Land Management or by a decree of a Court of Law and for that the corner points mentioned in lines 3, 4 and 5 above were in conformance with the rules of the Michigan Board of Land Surveyors or by a Decree of a Court of Law; established, re-established, monumented, recovered, found as expressed below:

NOTE: Not more than 2 corners, all in the same town and range, may be recorded on this certificate.

A. Description of original monument and accessories and/or subsequent restoration:

(M-12) - 1/4 Corner Common to Section 36, T51N, R39W, and Section 31, T51N, R38W

- 1845 - Austin Burt set a post
14" Hemlock S 07° E 74 links
14" Birch S 25° W 32 links

I found no subsequent Records.

B. Description of corner evidence found and/or method applied in restoring or reestablishing corner:

I found no remains of the original corner or accessories. I found a fence to the South, a powerline to the North and South, and a fenceline to the West. This position falls in a small creek bed. Longtime resident to the South, John Myllylahti, told me that the Corner used to be a pipe in the creek. I recovered a bent, buried 2" iron pipe in the creek at the mouth of a culvert. This pipe falls very close to a single prorated position. The pipe falls 4 feet East of the powerline and 4 feet South of the fence to the West. I accepted the bent pipe as the 1/4 Corner and replaced it with an iron pin in a pile of rocks.


Research on file with County Remonumentation Representative.

C. Description of monument for corner and accessories established to perpetuate locating the position of the corner:

Corner is a 5/8" x 48" iron pin with a 3" diameter aluminum cap stamped to read: COUNTY REMONUMENTATION; T.51N, R.39W, R.38W; 1/4; S.36, S.31; 1998; P.S. 37273.

- Witnesses:
14" Oak N 70° E 26.86'
Steel Sign Post S 26° E 4.87'
5" Hard Maple S 43° W 32.40'
8" Hard Maple S 72° W 23.21'
NE Cor. Section 36 N 00°15'10" W 2633.27'
SE Cor. Section 36 S 00°13'00" E 2638.74'

PEER GROUP APPROVED
Earl W Applekamp
COUNTY REMONUMENTATION
12-18-98

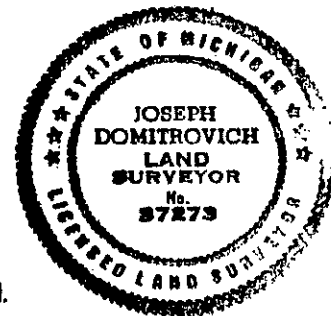

NOTE: Bearings to witness objects are magnetic. Distances are to a nail in side of the witness object unless noted.

Signed by J. C. Domitrovich

Date 12-18-98

Surveyor's Michigan License No. 37273