

SURVEY & REMONUMENTATION

DEC 16 1996

JUDITH D. ROEHM
Ontonagon County
LC 4/ 84 JEM Fee: 9.00
Page 1 of 1

COMMISSION LAND CORNER RECORDATION CERTIFICATE
Filing Requirement of Act 74, Mich. P.A. 1970

For corners in Ontonagon Located In: _____ Corner Code # _____
(County)

| | | | | | | |
|--------------------------------------|---|------------|---|------------|--------------------|-------|
| 1. Public Land Survey | T | <u>51N</u> | R | <u>39W</u> | <u>M-13 same</u> ✓ | |
| | T | <u>51N</u> | R | <u>38W</u> | <u>A-13 corner</u> | |
| | T | _____ | R | _____ | _____ | |
| | T | _____ | R | _____ | _____ | |
| 2. Property Controlling in Section | S | _____ | T | _____ | R | _____ |
| | S | _____ | T | _____ | R | _____ |
| 3. Miscellaneous Property in Section | S | _____ | T | _____ | R | _____ |
| | S | _____ | T | _____ | R | _____ |

Register of Deeds Stamp & File Number

4. Lot No. _____, Recorded Plat _____
5. Private Claims _____

| | | | | | | | | | | | | |
|----|----|----|----|----|----|----|----|----|---|---|---|---|
| A | B | C | D | E | F | G | H | I | J | K | L | M |

I, Joseph C. Domitrovich, in a field survey on June 5, 1996, do hereby certify that under requirements of P.A. 74, Michigan P.A. of 1970, the corner points mentioned in lines 1 and 2 above were in conformance with regulations and rules therefore as required in the current manual of survey instructions of the United States Department of the Interior, Bureau of Land Management or by a decree of a Court of Law and/or that the corner points mentioned in lines 3, 4 and 5 above were in conformance with the rules of the Michigan Board of Professional Surveyors or by a Decree of a Court of Law; established, re-established, monumented, re-monumented, recovered, found as expressed below:

NOTE: Not more than 4 corners, all in the same town and range, may be recorded on this certificate.

A. Description of original monument and accessories and/or subsequent restoration:
(A-13/M-13) Township Corner Section 36, T51N, R39W and Section 31, T51N, R38W

1845 - Austin Burt set post
14" Sugar N 18° E 41 links
9" Sugar S 18° W 42 links

B. Description of corner evidence found and/or method applied in restoring or reestablishing corner:
Found the intersection of partially fallen fences to north, west and east at corner position. Found no remains of original corner or accessories. This corner is the southeast property corner of a farm that has been owned by the Myllylahti family since the early 1900's. This position works well with standard and closing corners to the east and west.


I accepted this position as the township corner and have monumented it as such.

PEER GROUP APPROVED
Paul W. Applekamp
COUNTY REPRESENTATIVE 6-06-96

Research on file with County Remonumentation Representative.

C. Description of monument for corner and accessories established to perpetuate locating the position of the corner:
Corner is a 5/8" x 24" rebar driven into rock pile and capped with a 3" diameter aluminum cap stamped to read: T.51N., R.39W., R.38W.; S.C.; 1996; P.S. 37273

Witnesses:
12" Hard Maple North 0.91'
6" Ironwood N 33° E 17.92'
Steel Sign Post S 80° E 1.14'
8" White Ash S 05° E 20.89'
6" Basswood S 50° W 26.05'

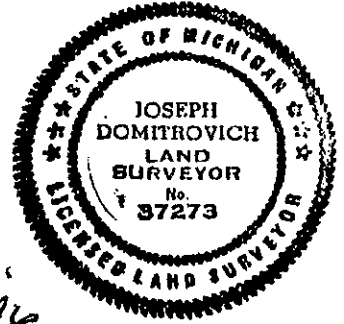

NOTE: Bearings are magnetic. Distances are to nail in side of witness objects unless noted.

Signed by Joseph C. Domitrovich Date 6/5/96
Surveyor's Michigan License No. 37273