

LAND CORNER RECORDATION CERTIFICATE

FILING REQUIREMENT OF ACT 74, MICH. P.A.1970

FOR CORNERS OF--:	LOCATED IN--:	CORNER CODE NUMBER
1. PUBLIC LAND SURVEY _____	T. <u>51</u> N. S., R. <u>40</u> E. W.	<u>M9, M8, K9</u>
2. PROPERTY CONTROLLING IN SECTION _____	T. _____ N. S., R. _____ E. W.	_____
3. MISCELLANEOUS PROPERTY IN SECTION _____	T. _____ N. S., R. _____ E. W.	_____
4. LOT NO. _____, RECORDED PLAT _____		
5. PRIVATE CLAIMS _____		

REGISTER OF DEEDS STAMP AND FILING NUMBER

I, Keith L. Sackett, do hereby certify that under requirements of P.A. 74, Michigan P.A. of 1970, the corner points mentioned in lines 1 and 2 above were, in a field survey on see below, 19____, established, re-established, monumented, re-monumented, recovered or restored as expressed below and in conformance with regulations and rules therefore as required in the current manual of survey instructions of the United States Department of the Interior, Bureau of Land Management or by a decree of a court of law. Furthermore, that the corner points mentioned in lines 3, 4 and 5 above were, in a field survey on _____, 19____, found, recovered, restored, established or re-established as expressed below and in conformance with the rules of the Michigan State Board of Registration for Land Surveyors or, by a Decree of a Court of law:

A. Description of original monument and accessories and/or subsequent restoration:

- Corner M-9: Original monument and accessories not found.
- Corner M-8: Original monument and accessories not found. Found squared scribed balsam used as temporary corner. Monument is 45.44 ft. north and 47.78 ft. east of squared scribed balsam.
- Corner K-9: Original monument and accessories not found. Found old fence corner.

B. Description of corner evidence found and/or method applied in restoring or re-establishing corner:

- Corner M-9: Re-established 11-9-76 on township line between corners north and south.
- Corner M-8: Re-established 11-9-76 on township line between corners north and south.
- Corner K-9: Re-established 11-10-76 at old fence corner. This fence corner fits good with other corners in area.

C. Description of monument for corner and accessories established to perpetuate locating the position of the corner:

- | | |
|--|--|
| <p><u>Corner M-9</u>: Set 1" I.D. x 36" iron pipe with 4" aluminum cap.</p> <ul style="list-style-type: none"> 6" Y. Birch N70°W 22.1 ft. S24, NBT 10" Elm N59°E 24.3 ft. S19, NBT 14" Sugar S03°W 4.5 ft. S30, NBT 4" Balsam S52°E 4.5 ft. Squared <p><u>Corner K-9</u>: Set 1" I.D. x 36" iron pipe with 4" aluminum cap.</p> <ul style="list-style-type: none"> 4" Sugar S01°W 6.4 ft. S26, NBT 5" Sugar S87°E 27.5 ft. S25, NBT 5" Sugar N69°W 8.2 ft. S23, NBT | <p><u>Corner M-8</u>: Set 1" I.D. x 36" iron pipe with 4" aluminum cap.</p> <ul style="list-style-type: none"> 3" Maple N53°W 15.6 ft. ¼S, NBT 8" Maple N66°E 14.4 ft. ¼S, NBT 4" Maple S35°W 23.8 ft. ¼S, NBT 2" Maple West 3.0 ft. Squared |
|--|--|


SIGNED BY _____ DATE _____

SURVEYOR'S MICHIGAN REGISTRATION NO. _____ (SEAL)

FOR STATE AND UNITED STATES AGENCIES:

SIGNED BY Michael W. Roose Michael W. Roose DATE 12/28/76
CHIEF OF SURVEY PARTY

APPROVED AND SIGNED BY Keith L. Sackett DATE _____
MICHIGAN REGISTERED LAND SURVEYOR
 Keith L. Sackett

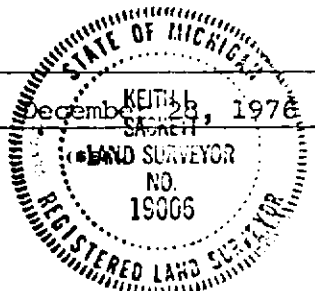

SURVEYOR'S MICHIGAN REGISTRATION NO. 19006