

LAND CORNER RECORDATION CERTIFICATE
 Filing Requirement of Act 74, Mich. P.A. 1970

For corners in

Ontonagon
 (County)

Located In:

Corner Code #

North D. ROEHM 06/13/97
 Ontonagon County 15:30
 LC 4/285 JTT Fee: 9.00
 Page 1 of 1

COUNTY OF
REMONUMENTATION

OCT 30 1997

COMMISSION

Register of Deeds Stamp & File Number

1. Public Land Survey	T <u>51N</u> R <u>40W</u>	✓ <u>A-4</u> Same
	T <u>51N</u> R <u>41W</u>	<u>M-4</u> Corner
	T ___ R ___	_____
	T ___ R ___	_____
2. Property Controlling in Section	S ___ T ___ R ___	_____
	S ___ T ___ R ___	_____
3. Miscellaneous Property in Sec.	S ___ T ___ R ___	_____
	S ___ T ___ R ___	_____

4. Lot No. _____, Recorded Plat _____
 5. Private Claims _____

I, Joseph C. Domitrovich, in a field survey on June 4, 19 97 do hereby state that under requirements of P.A. 74, Michigan P.A. of 1970, the corner points mentioned in lines 1 and 2 above were in conformance with regulations and rules therefore as required in the current manual of survey instructions of the United States Department of the Interior, Bureau of Land Management or by a decree of a Court of Law and for that the corner points mentioned in lines 3, 4 and 5 above were in conformance with the rules of the Michigan Board of Land Surveyors or by a Decree of a Court of Law; established, re-established, monumented, recovered, found as expressed below:

NOTE: Not more than 2 corners, all in the same town and range, may be recorded on this certificate.

(A-4/M-4) 1/4 Corner Common to Sections 7 and 12, T51N, R40/41W

A. Description of original monument and accessories and/or subsequent restoration:

1845 - Austin Burt, D.S., set post
 10" Birch S 60° E 22 links
 14" Birch N 43° W 9 links

B. Description of corner evidence found and/or method applied in restoring or reestablishing corner:

Original corner and accessories have been destroyed by North-South Townline Road. I found two iron pipes at the base of the westerly most fencepost of an old fenceline to the East.

I re-established the quarter corner at the intersection of the extension of the fenceline with the centerline of Townline Road. This position works well with corners to the North and South.

Research on file with County Remonumentation Representative.

C. Description of monument for corner and accessories established to perpetuate locating the position of the corner:

Corner is a 5/8" iron pin with a 3" diameter aluminum cap stamped to read: COUNTY REMONUMENTATION, T. 51N, R. 40W, R. 41W; 1/4; S. 7, S. 12; 1997; P.S. 37273. I also placed a reference monument (R. M.) to the West, a 2" x 30" aluminum pipe with a 3" diameter aluminum cap, stamped to indicate that the corner is East 32.18'.

10" Ash	N 35° E	47.16'	
Iron Pipe	East	31.79'	(1 1/2" galvanized iron pipe 18" above ground)
14" Soft Maple	S 35° E	42.46'	
10" Twin Soft Maple	S 59° W	75.32'	
Reference Monument	N 88° 43' 15" W	32.18'	
NW Corner Sec. 7	N 00° 11' 05" E	2643.00'	
SW Corner Sec. 7	S 00° 16' 55" W	2625.23'	


NOTE: Bearings are magnetic. Distances are to nail in side of witness objects unless noted.

Signed by Joseph C. Domitrovich

Date 6/9/97

Surveyor's Michigan License No. 37273

PEER GROUP APPROVED
John W. [Signature]
 COUNTY REPRESENTATIVE 6-10-97

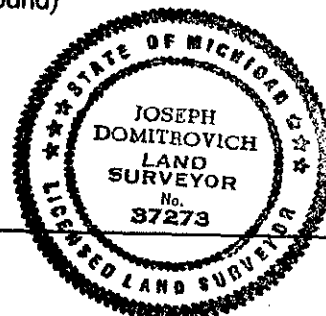

A	B	C	D	E	F	G	H	I	J	K	L	M
1												
2	6	5		4		3		2		1		
3												
4	7	8	9	10	11	12						
5												
6	18	17	16	15	14	13						
7												
8	19	20	21	22	23	24						
9												
10	30	29	28	27	26	25						
11												
12	31	32	33	34	35	36						
13												