

LAND CORNER RECORDATION CERTIFICATE
 Filing Requirement of Act 74, Mich. P.A. 1970

For corners in

<u>Ontonagon</u> (County)	Located In:	Corner Code #
1. Public Land Survey	T 51N R 40W	A-8 Same
	T 51N R 41W	M-8 Corner
	T ___ R ___	_____
	T ___ R ___	_____
2. Property Controlling in Section	S ___ T ___ R ___	_____
	S ___ T ___ R ___	_____
3. Miscellaneous Property in Sec.	S ___ T ___ R ___	_____
	S ___ T ___ R ___	_____

COUNTY OF
 REMONUMENTATION
 OCT 30 1997
 COMMISSION

Register of Deeds Stamp & File Number

4. Lot No. _____, Recorded Plat _____
 5. Private Claims _____

I, Joseph C. Domitrovich, in a field survey on June 4, 1997 do hereby state that under requirements of P.A. 74, Michigan P.A. of 1970, the corner points mentioned in lines 1 and 2 above were in conformance with regulations and rules therefore as required in the current manual of survey instructions of the United States Department of the Interior, Bureau of Land Management or by a decree of a Court of Law and /or that the corner points mentioned in lines 3, 4 and 5 above were in conformance with the rules of the Michigan Board of Land Surveyors or by a Decree of a Court of Law; established, re-established, monumented, recovered, found as expressed below:

NOTE: Not more than 2 corners, all in the same town and range, may be recorded on this certificate.

	A	B	C	D	E	F	G	H	I	J	K	L	M
1													
2	6		5		4		3		2		1		
3													
4	7		8		9		10		11		12		
5													
6	18		17		16		15		14		13		
7													
8	19		20		21		22		23		24		
9													
10	30		29		28		27		26		25		
11													
12	31		32		33		34		35		36		
13													

(A-8/M-8) 1/4 Corner Common to Sections 19 and 24, T 51N, R40/41W

A. Description of original monument and accessories and/or subsequent restoration:

- 1845 - Austin Burt, D.S., set post
- 12" Hemlock N 09° W 22 links
- 14" Hemlock N 55 1/2° E 28 links

B. Description of corner evidence found and/or method applied in restoring or reestablishing corner:

Original corner and accessories have been destroyed by road construction. I re-established the corner midway and on line between section corners to the North and South. The corner works well with others in the area.

Research on file with County Remonumentation Representative.


C. Description of monument for corner and accessories established to perpetuate locating the position of the corner:

Corner is a 5/8" iron pin with a 3" diameter aluminum cap stamped to read: COUNTY REMONUMENTATION, T. 51N, R. 40W, R. 41W; 1/4; S. 24, S. 19; 1997; P.S. 37273. I also placed a reference monument (R. M.) to the East, a 2" x 30" aluminum pipe with a 3" diameter aluminum cap, stamped to indicate that the corner is West 37.06'.

Witnesses:

- Power Pole S 78° E 37.52'
- 8" Ash S 32° W 56.49'
- 7" Red Pine N 39° W 32.92'
- Reference Monument N 88° 02' 23" E 37.06'
- NW Corner Sec. 19 N 00° 14' 12" E 2640.58'
- SW Corner Sec. 19 S 00° 14' 12" W 2640.58'

BEER GROUP APPROVED
Carl W Applekamp
 COUNTY REPRESENTATIVE 6-10-97

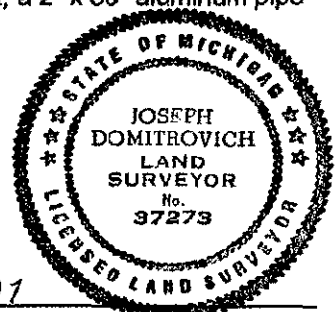

NOTE: Bearings are magnetic. Distances are to nail in side of witness objects unless noted.

Signed by Joseph C. Domitrovich
 Surveyor's Michigan License No. 37273

Date 6/9/97