

LAND CORNER RECORDATION CERTIFICATE
 Filing Requirement of Act 74, Mich. P.A. 1970

06-13-97
 15:32

For corners in

LC 4 287 JJJ Fee: 9.00
 Page 1 of 1

| | | |
|------------------------------------|-------------------|---------------|
| <u>Ontonagon</u> (County) | Located In: | Corner Code # |
| 1. Public Land Survey | T 51N R 40W | A-13 ✓ Same |
| | T 51N R 41W | M-13 Corner |
| | T ___ R ___ | _____ |
| | T ___ R ___ | _____ |
| 2. Property Controlling in Section | S ___ T ___ R ___ | _____ |
| | S ___ T ___ R ___ | _____ |
| 3. Miscellaneous Property in Sec. | S ___ T ___ R ___ | _____ |
| | S ___ T ___ R ___ | _____ |

COUNTY REMONUMENTATION

OCT 30 1997

COMMISSION
 Register of Deeds Stamp & File Number

4. Lot No. _____, Recorded Plat _____
 5. Private Claims _____

I, Joseph C. Domitrovich, in a field survey on June 5, 19 97 do hereby state that under requirements of P.A. 74, Michigan P.A. of 1970, the corner points mentioned in lines 1 and 2 above were in conformance with regulations and rules therefore as required in the current manual of survey instructions of the United States Department of the Interior, Bureau of Land Management or by a decree of a Court of Law and/or that the corner points mentioned in lines 3, 4 and 5 above were in conformance with the rules of the Michigan Board of Land Surveyors or by a Decree of a Court of Law, established, re-established, monumented, recovered, found as expressed below:

NOTE: Not more than 2 corners, all in the same town and range, may be recorded on this certificate.

| A | B | C | D | E | F | G | H | I | J | K | L | M |
|---|----|----|----|----|----|----|---|---|---|---|---|---|
| | 6 | 5 | 4 | 3 | 2 | 1 | | | | | | |
| | | | | | | | | | | | | |
| | 7 | 8 | 9 | 10 | 11 | 12 | | | | | | |
| | | | | | | | | | | | | |
| | 18 | 17 | 16 | 15 | 14 | 13 | | | | | | |
| | | | | | | | | | | | | |
| | 19 | 20 | 21 | 22 | 23 | 24 | | | | | | |
| | | | | | | | | | | | | |
| | 30 | 29 | 28 | 27 | 26 | 25 | | | | | | |
| | | | | | | | | | | | | |
| | 31 | 32 | 33 | 34 | 35 | 36 | | | | | | |
| | | | | | | | | | | | | |

(A-13/M-13) Township Corner of Sections 31 and 36, T 51N, R40/41W

A. Description of original monument and accessories and/or subsequent restoration:

1845 - Austin Burt, D.S., set post
 14" Maple N 61° E 23 links
 7" Maple N 29° W 6 links

Corner is a standard corner on the 5th correction line.

B. Description of corner evidence found and/or method applied in restoring or reestablishing corner:

Bill Myhren, a resident of Townline Road since 1919, showed me an 18" diameter stone with markings chiseled on it. This stone was shown to him when he was a boy. Mr. Myhren believes the stone is the original corner. I found no remains of the original bearing trees, but the stone has been used as the Township Corner for the construction of Townline Road to the North and a county road to the West. The stone is very old. It has the following chiseled on it: S. 31, 36, 51N. The distance West to a 3" iron pipe at the closing corner works well with GLO distance.

PEER GROUP APPROVED
Carl W. Applekamp
 COUNTY REPRESENTATIVE 6-10-97


Research on file with County Remonumentation Representative.

C. Description of monument for corner and accessories established to perpetuate locating the position of the corner:

Corner is a 1/2" iron pin embedded in an 18" diameter marked stone. The iron pin is capped with a 3" diameter aluminum cap stamped: COUNTY REMONUMENTATION; T. 51N, R. 40W, R. 41W; S. 31, S. 36; S.C.; 1997; P.S. 37273.

Witnesses:

| | | | |
|----------------------|-----------------|----------|--------------|
| 3" Oak | N 04° E | 25.82' | |
| 3" Poplar | East | 13.96' | |
| Steel Sign Post | South | 1.02' | (to face) |
| 1/2" rebar set | S 16° W | 16.37' | |
| 4" Poplar | S 73° W | 42.57' | |
| Closing Corner | N 89° 21' 39" E | 2162.68' | (2174.7 GLO) |
| W 1/4 Corner Sec. 31 | N 00° 30' 50" W | 2634.90' | |

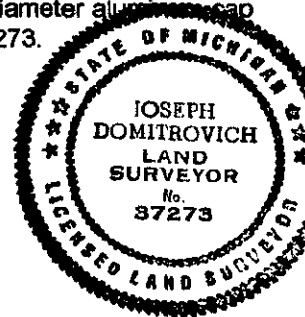

NOTE: Bearings are magnetic. Distances are to nail in side of witness objects unless noted.
 Signed by Joseph C. Domitrovich Date 6/9/97

Surveyor's Michigan License No. 37273