

LAND CORNER RECORDATION CERTIFICATE
 Filing Requirement of Act 74, Mich. P.A. 1970

For corners in

Ontonagon
 (County)

Located In:

Corner Code #

1. Public Land Survey

T 51N R 40W	B-3
T ___ R ___	_____
T ___ R ___	_____
T ___ R ___	_____
T ___ R ___	_____
S ___ T ___ R ___	_____
S ___ T ___ R ___	_____
S ___ T ___ R ___	_____
S ___ T ___ R ___	_____

2. Property Controlling in Section

3. Miscellaneous Property in Sec.


4. Lot No. _____, Recorded Plat _____
 5. Private Claims _____

SURVEY & REMONUMENTATION

MAY 22 1997

COMMISSION

Register of Deeds Stamp & File Number

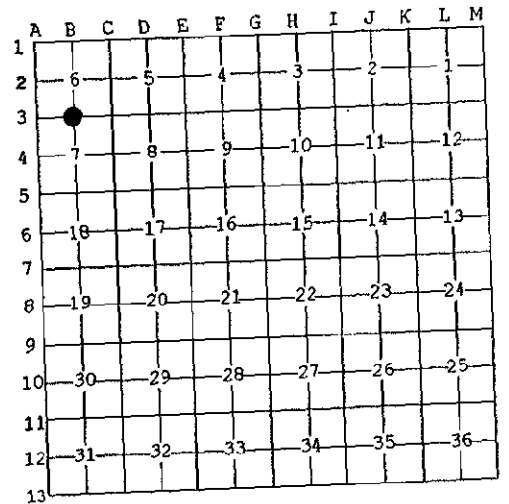

I, Joseph C. Domitrovich, in a field survey on November 1, 1996 do hereby state that under requirements of P.A. 74, Michigan P.A. of 1970, the corner points mentioned in lines 1 and 2 above were in conformance with regulations and rules therefore as required in the current manual of survey instructions of the United States Department of the Interior, Bureau of Land Management or by a decree of a Court of Law and for that the corner points mentioned in lines 3, 4 and 5 above were in conformance with the rules of the Michigan Board of Land Surveyors or by a Decree of a Court of Law; established, re-established, monumented, recovered, found as expressed below:

NOTE: Not more than 2 corners, all in the same town and range, may be recorded on this certificate.

(B-3) 1/4 Corner Common to Sections 6 & 7, T51N, R 40W

A. Description of original monument and accessories and/or subsequent restoration:

1845 - William A. Burt set Cedar post.

- 12" Cedar N 72° E 15 links
- 10" Cedar N 05° W 15 links

1940 - Thomas A. Wilcox, C.E., in Supervisor's Plats of Government Lots 1, 2, 3, & 4, Section 6, T51N, R40W, shows a concrete monument set at this corner and gives distances to section corners to East and West.

1969 - M-64 Highway plans found a 3/4" iron pipe and gave 3 witnesses, and angle and distance off centerline to it.

1979 - William H. Riipi, P.S. 19842, in survey for Walt Hibbeln, found a broken concrete monument 10" below surface with iron pin missing.

B. Description of corner evidence found and/or method applied in restoring or reestablishing corner:

I found the base of a 4" square concrete monument in 2 pieces 10" below ground with a 1 1/4" OD pipe driven next to it. The concrete monument had no iron in it. The iron pipe works very well with angles and distances off centerline M-64. The concrete monument works reasonably well with other recovered monuments in the plats and it also works well with Riipi distance to West.

I believe the iron pipe was driven next to the monument to provide magnetic attraction, since the monument had no iron in it. I therefore accepted the concrete monument as the 1/4 corner and replaced it with a county monument. I left the iron pipe in place beside it.

Research on file with County Remonumentation Representative.

C. Description of monument for corner and accessories established to perpetuate locating the position of the corner:


Corner is a 2" x 30" aluminum pipe with a 3" diameter aluminum cap stamped to read: 1/4; S. 6, S. 7; T.51N, R.40W; 1996; P.S. 37273; COUNTY REMONUMENTATION. Corner falls 32' North of a fence line down the hill to the East and on extension of trail to the North.

Witnesses:

- 5" Hard Maple N 09° W 36.92'
- 10" Balsam Fir S 61° E 8.65'
- 10" Hard Maple S 11° E 26.34'
- Steel Sign Post South 0.93'
- 6" Hard Maple N 56° W 19.02'

BEER GROUP APPROVED
Carl W. Applbaum
 COUNTY REPRESENTATIVE

11-11-96

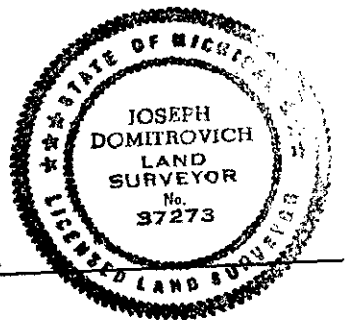

NOTE: Bearings are magnetic. Distances are to nail in side of witness objects unless noted.

Signed by Joseph C. Domitrovich
 Surveyor's Michigan License No. 37273

Date 11/10/96