

SURVEY & REMONUMENTATION

DEC 1 8 1996

COMMISSION

JUDITH D. ROEHN
Ontonagon County
LC 4/ 36 JEM Feet: 9.00
Page 1 of 1


LAND CORNER RECORDATION CERTIFICATE
Filing Requirement of Act 74, Mich. P.A. 1970

For corners in Ontonagon (County) Located In: _____ Corner Code # _____

1. Public Land Survey	T	51N	R	40W	B-9
	T	_____	R	_____	_____
	T	_____	R	_____	_____
	T	_____	R	_____	_____
2. Property Controlling in Section	S	_____	T	_____	R
	S	_____	T	_____	R
3. Miscellaneous Property in Section	S	_____	T	_____	R
	S	_____	T	_____	R

4. Lot No. _____, Recorded Plat _____
5. Private Claims _____

Register of Deeds Stamp & File Number

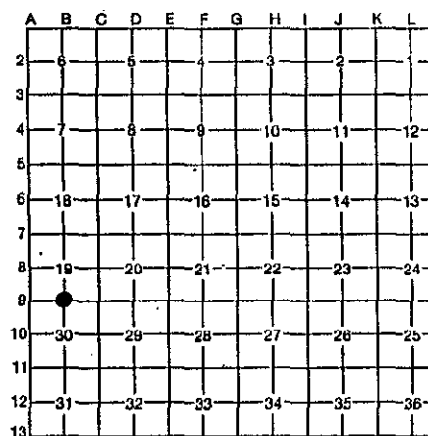

I, Joseph C. Domitrovich, in a field survey on September 26, 1995, do hereby certify that under requirements of P.A. 74, Michigan P.A. of 1970, the corner points mentioned in lines 1 and 2 above were in conformance with regulations and rules therefore as required in the current manual of survey instructions of the United States Department of the Interior, Bureau of Land Management or by a decree of a Court of Law and/or that the corner points mentioned in lines 3, 4 and 5 above were in conformance with the rules of the Michigan Board of Professional Surveyors or by a Decree of a Court of Law; established, re-established, monumented, re-monumented, recovered, found as expressed below:

NOTE: Not more than 4 corners, all in the same town and range, may be recorded on this certificate.

A. Description of original monument and accessories and/or subsequent restoration:

(B-9) 1/4 Corner common to Sections 19 & 30, T51N R40W

1845 - William A. Burt set Elm post
7" Y. Birch N 63° E 25 links
8" Hemlock N 47° W 24 links

B. Description of corner evidence found and/or method applied in restoring or reestablishing corner:

All remains of original corner and bearing trees have been removed by farming and road construction. The intersection of a very old fallen fence to the north and the centerline of an east-west gravel road is the only remaining evidence of the corner position. This intersection works well with GLO distances east and west to section corners and I have determined it to be the best position for the 1/4 corner and have monumented it as such.

PEER GROUP APPROVED
Earl W. Appeltkamp
COUNTY REPRESENTATIVE 3-27-96

Research on file with County Remonumentation Representative

C. Description of monument for corner and accessories established to perpetuate locating the position of the corner:

Corner is a 3/4" aluminum rod with a 3" diameter stamped aluminum cap and falls in centerline of east-west Quariz road on the extension of an old fallen fence to the north. Corner falls 6' east of the extension of a newer electric fence to the north.

Witnesses

Top of metal corner fencepost	N 12° E	40.18'
Top of metal corner fencepost	S 22° E	35.96'
Stamped Aluminum Reference Monument	South	26.50'
Metal sign post	South	27.17'
10" Poplar	S 27° W	53.18'



NOTE: Bearings are magnetic. Distances are to nail in side of witness objects unless noted.

Signed by J. C. Domitrovich Date 3/26/96
Surveyor's Michigan License No. 37273