

**LAND CORNER RECORDATION CERTIFICATE**  
 Filing Requirement of Act 74, Mich. P.A. 1970

For corners in

Ontonagon Located In: Corner Code #  
 (County)

1. Public Land Survey T 51N R 40W B-11  
 T R  
 T R  
 T R

2. Property Controlling S T R  
 in Section S T R

3. Miscellaneous S T R  
 Property in Sec. S T R

REGISTERED  
 REMONUMENTATION  
 OCT 30 1997  
 COMMISSION  
 Register of Deeds Stamp & File Number

4. Lot No. \_\_\_\_\_, Recorded Plat \_\_\_\_\_  
 5. Private Claims \_\_\_\_\_

I, Joseph C. Domitrovich, in a field survey on June 5, 19 97 do hereby state that under requirements of P.A. 74, Michigan P.A. of 1970, the corner points mentioned in lines 1 and 2 above were in conformance with regulations and rules therefore as required in the current manual of survey instructions of the United States Department of the Interior, Bureau of Land Management or by a decree of a Court of Law and/or that the corner points mentioned in lines 3, 4 and 5 above were in conformance with the rules of the Michigan Board of Land Surveyors or by a Decree of a Court of Law; established, re-established, monumented, recovered, found as expressed below:

NOTE: Not more than 2 corners, all in the same town and range, may be recorded on this certificate.

	A	B	C	D	E	F	G	H	I	J	K	L	M
1													
2	6		5		4		3		2		1		
3													
4	7		8		9		10		11		12		
5													
6	18		17		16		15		14		13		
7													
8	19		20		21		22		23		24		
9													
10	30		29		28		27		26		25		
11	●												
12	31		32		33		34		35		36		
13													

**(B-11) 1/4 Corner Common to Sections 30 and 31, T 51N, R40W**

A. Description of original monument and accessories and/or subsequent restoration:

1845 - William A. Burt, D.S., set post.  
 30" Hemlock N 62° E 20 links  
 18" Hemlock N 80° W 32 links

R.S. Scott Engineering for L.P. Walsh Highway Construction Plans on file at Ontonagon County Road Commission office, show 1/4 corner in place, 548.52; West of centerline of proposed highway. Plans do not indicate what the corner is.

B. Description of corner evidence found and/or method applied in restoring or reestablishing corner:

I found no remains of original corner or accessories. I found a 1 1/2" iron pipe 4' South of the middle of an old roadbed running to the West. This pipe works well with other corners in area: SW corner Section 30 is West 2781.17' (2798.4' GLO)  
 N 1/4 corner Section 30 is North 5272.17'.

The distance East to present centerline of L.P. Walsh does not match Highway plans. (453' measured.)  
 I accepted the pipe as the 1/4 corner since it is consistent with other corners and disregarded L.P. Walsh Highway Plans distance.

Research on file with County Remonumentation Representative.


C. Description of monument for corner and accessories established to perpetuate locating the position of the corner:

Corner is a 3/4" x 48" aluminum rod driven inside a 1 1/2" iron pipe and capped with a 3" diameter aluminum cap stamped to read: COUNTY REMONUMENTATION; T.51N, R. 40W; 1/4; S. 30, S. 31; 1997; P.S. 37273.

**Witnesses:**

6" Poplar N 45° E 14.47'  
 7" Hard Maple S 40° E 34.33'  
 Steel Sign Post South 0.68' (to face)  
 10" Spruce S 61° W 30.21'  
 12" Balsam N 26° W 22.50'

PEER GROUP APPROVED  
*Paul W. Applebaum*  
 COUNTY REPRESENTATIVE  
 6-10-97

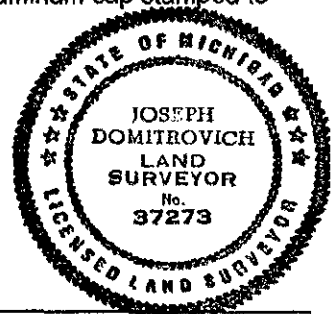

NOTE: Bearings are magnetic. Distances are to nail in side of witness objects unless noted.

Signed by Joseph C. Domitrovich Date 6/9/97  
 Surveyor's Michigan License No. 37273