SURVEY &
REMONUMENTATION

APR 2 5 1995

COMMISSION

LAND CORNER RECORDATION CERTIFICATE

Filing Requirement of Act 74, Mich. P.A. 1970

For corners in ONTONAGON (County)

	Located In:	Corner Code #
1. Public Land Survey	T 51 R 40	C-3
	T ___ R ___	
	T ___ R ___	
	T ___ R ___	
2. Property Controlling	S ___ T ___ R ___	
in Section	S ___ T ___ R ___	
3. Miscellaneous	S ___ T ___ R ___	
Property in Sec.	S ___ T ___ R ___	

Recorded December 19 1994
at 2:30 o'clock P. M. in
Liber Survey 3 page 246
Julie M. Dey Deputy
Register of Deeds

Register of Deeds Stamp & File Number

4. Lot No. _____ , Recorded Plat _____
5. Private Claims _____

Section Corner 6, 5, 8 &7 T51N R40W

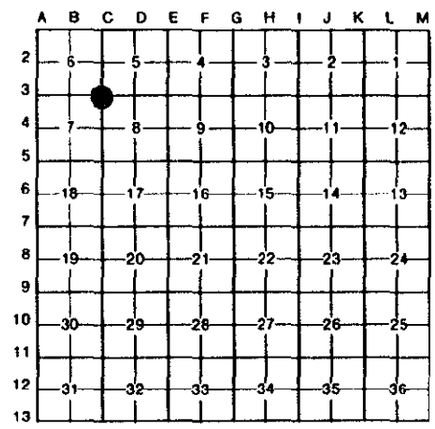

I, Earl W. Applekamp, in a field survey on November 25, 19 94, do hereby certify that under requirements of P.A. 74, Michigan P.A. of 1970, the corner points mentioned in lines 1 and 2 above were in conformance with regulations and rules therefore as required in the current manual of survey instructions of the United States Department of the Interior, Bureau of Land Management or by a decree of a Court of Law and/or that the corner points mentioned in lines 3, 4 and 5 *above were in conformance with the rules of the Michigan Board of Land Surveyors or by a Decree of a* Court of Law; established, re-established, monumented, re-monumented, recovered, found as expressed below:

NOTE: Not more than 4 corners, all in the same town and range, may be recorded on this certificate.

A. Description of original monument and accessories and/or subsequent restoration:

Original Corner established by William A. Burt, U.S. Deputy Surveyor, September 1845. Set a Maple Post. Ties to original post.

10"	Hemlock	S62°E	22 Links	(14.52 feet)
24"	Hemlock	N37°W	67 Links	(44.22 feet)

In the mid 1960's a 1" capped pipe was set by Scott Engineering to mark the corner.

ONTONAGON COUNTY PEER APPROVED
Earl W Applekamp
ont to Rep
12-15-94

B. Description of corner evidence found and/or method applied in restoring or reestablishing corner:

I found the corner set by Scott Engineering. This corner has been used for several surveys in the area and for construction of the L.P. Walsh Road in 1967. The corner is in agreement with the corner 1 mile to the South and with occupation lines in the area. I accepted the 1" capped pipe and remonumented the corner as shown in Item C.

Research on file with the County Remonumentation Program Representative.

C. Description of monument for corner and accessories *established to perpetuate locating the position of the corner:*

At the corner position I set a $2\frac{1}{4}$"x30" aluminum pipe with a $3\frac{1}{4}$" Cap stamped to read: County Remonumentation, S. 6, S. 5, S. 7, S. 8, T51N R40W, 1994, P.S. 17610. I tied the corner to the following objects and trees.

4" Apple tree	N78°W	25.13 feet
4" Scotch Pine	S31°W	40.93 feet
5" White Birch	S17°E	34.85 feet
Steel Sign Post	East	0.85 fee

STATE OF MICHIGAN
EARL W. APPLEKAMP
PROFESSIONAL SURVEYOR
NO. 17610
LICENSED PROFESSIONAL SURVEYOR

Signed by Earl W Applekamp Date December 12, 1994

Surveyor's Michigan License No. 17610

FORM APPROVED BY MICHIGAN STATE BOARD OF LAND SURVEYORS, JAN. 28, 19
REVISED MAY 14, 19
REVISED JAN., 19