

JUDITH D. ROEHN
 Ontonagon County
 LC 4/280 JJI

06/13/97
 15:27
 Feet: 9.00
 Page 1 of 1

LAND CORNER RECORDATION CERTIFICATE
 Filing Requirement of Act 74, Mich. P.A. 1970


For corners in

<u>Ontonagon</u> (County)	Located In:	Corner Code #
1. Public Land Survey	T <u>51N</u> R <u>40W</u>	<u>C-5</u>
	T ___ R ___	_____
	T ___ R ___	_____
	T ___ R ___	_____
2. Property Controlling in Section	S ___ T ___ R ___	_____
	S ___ T ___ R ___	_____
3. Miscellaneous Property in Sec.	S ___ T ___ R ___	_____
	S ___ T ___ R ___	_____

REMONUMENTATION
 OCT 30 1997
 COMMISSION
 Register of Deeds Stamp & File Number

4. Lot No. _____, Recorded Plat _____
 5. Private Claims _____

I, Joseph C. Domitrovich, in a field survey on June 9, 1997 do hereby state that under requirements of P.A. 74, Michigan P.A. of 1970, the corner points mentioned in lines 1 and 2 above were in conformance with regulations and rules therefore as required in the current manual of survey instructions of the United States Department of the Interior, Bureau of Land Management or by a decree of a Court of Law and for that the corner points mentioned in lines 3, 4 and 5 above were in conformance with the rules of the Michigan Board of Land Surveyors or by a Decree of a Court of Law; established, re-established, monumented, recovered, found as expressed below:

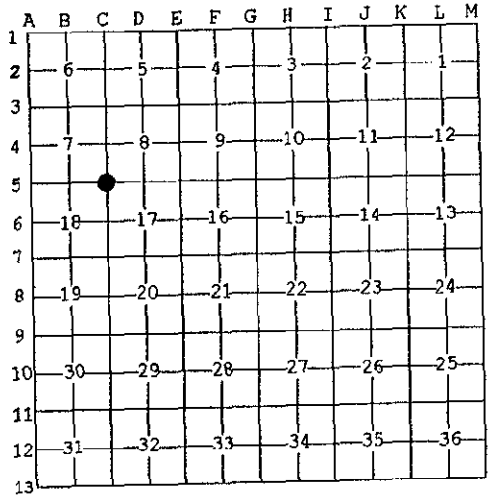

NOTE: Not more than 2 corners, all in the same town and range, may be recorded on this certificate.

(C-5) Corner of Sections 7, 8, 17 and 18, T51N, R40W

A. Description of original monument and accessories and/or subsequent restoration:

- 1845 - William A. Burt, D.S., set Fir post.
 8" Cedar S 62° W 37 links
 12" Sugar N 16° E 36 links
- 1967 - R.S. Scott Engineering for L.P. Walsh Highway Construction Plans (on file at Ontonagon County Road Commission office) show a 1" iron pipe at corner and 3 witnesses: 18" Poplar N 70° E 71.80', 10" Poplar N 85° E 71.85', 12" Apple S 45° E 86.85'.
- 1984 - Earl Applekamp, P.S. 17610, in survey in Section 7, shows a 1" iron pipe at the corner. He used it to re-establish the 1/4 corner to the North by single proportionate measurement.

B. Description of corner evidence found and/or method applied in restoring or reestablishing corner:

I found no remains of original corner or accessories. The 1" iron pipe found by R.S. Scott and Earl Applekamp has been paved over and bent. I recreated the position of the pipe from the Earl Applekamp survey. I also found two remaining R.S. Scott Witnesses. Distances from these to the recreated position check well.

I accepted the position of the iron pipe as the Section Corner and replaced it with P.K. nail and two reference monuments. The corner falls in centerline of L.P. Walsh Road and on the extension of fences East and West. The corner works well with corners to North and South:
 E 1/4 Corner Section 7 N 00° 09' 07" E 2643.86'
 E 1/4 Corner Section 18 S 00° 29' 37" E 2625.59'

Research on file with County Remonumentation Representative.

PEER GROUP APPROVED
Earl W. Applekamp
 COUNTY REPRESENTATIVE 6-10-97

C. Description of monument for corner and accessories established to perpetuate locating the position of the corner.
 Corner is a P.K. nail in centerline of L.P. Walsh Rd., referenced by two monuments. The first reference monument (R.M. 1) was placed to the Southwest, a 2" x 30" aluminum pipe with a 3" diameter aluminum cap stamped to indicate that the Section Corner is N 47° E 54.77 feet. The second monument (R.M. 2) is the same type, stamped to indicate that the Section Corner is S 89° W 47.83 feet.

Witnesses:

6" White Pine	N 55° W	67.07'	(P.K. nail in side)
18" Poplar	N 53° E	71.78'	(R.S. Scott witness)
12" Poplar	N 84° E	71.85'	(R.S. Scott witness)
R.M. 2	N 89° 29' 26" E	47.83'	
R.M. 1	S 46° 58' 19" W	54.77'	

NOTE: Bearings are magnetic. Distances are to nail in side of witness objects unless noted.
 Signed by Joseph C. Domitrovich Date 6/9/97

Surveyor's Michigan License No. 37273

