

**LAND CORNER RECORDATION CERTIFICATE**  
**Filing Requirement of Act 74, Mich. P.A. 1970**

For corners in

JUDITH D. ROEHM  
 Ontonagon County  
 LC 4/289 JTT Fee: 9.00  
 Page 1 of 1  
 06/13/97  
 15:34

|                                       |                           |               |
|---------------------------------------|---------------------------|---------------|
| <u>Ontonagon</u><br>(County)          | Located In:               | Corner Code # |
| 1. Public Land Survey                 | T <u>51N</u> R <u>40W</u> | <u>C-6</u>    |
|                                       | T ___ R ___               | _____         |
|                                       | T ___ R ___               | _____         |
|                                       | T ___ R ___               | _____         |
| 2. Property Controlling<br>in Section | S ___ T ___ R ___         | _____         |
|                                       | S ___ T ___ R ___         | _____         |
| 3. Miscellaneous<br>Property in Sec.  | S ___ T ___ R ___         | _____         |
|                                       | S ___ T ___ R ___         | _____         |

REMONUMENTATION

OCT 30 1997

COMMISSION

Register of Deeds Stamp & File Number

4. Lot No. \_\_\_\_\_, Recorded Plat \_\_\_\_\_  
 5. Private Claims \_\_\_\_\_

I, Joseph C. Domitrovich, in a field survey on June 9, 19 97 do hereby state that under requirements of P.A. 74, Michigan P.A. of 1970, the corner points mentioned in lines 1 and 2 above were in conformance with regulations and rules therefore as required in the current manual of survey instructions of the United States Department of the Interior, Bureau of Land Management or by a decree of a Court of Law and /or that the corner points mentioned in lines 3, 4 and 5 above were in conformance with the rules of the Michigan Board of Land Surveyors or by a Decree of a Court of Law, established, re-established, monumented, recovered, found as expressed below:

NOTE: Not more than 2 corners, all in the same town and range, may be recorded on this certificate.

|    |    |   |    |   |    |   |    |   |    |   |    |   |   |
|----|----|---|----|---|----|---|----|---|----|---|----|---|---|
|    | A  | B | C  | D | E  | F | G  | H | I  | J | K  | L | M |
| 1  |    |   |    |   |    |   |    |   |    |   |    |   |   |
| 2  | 6  |   | 5  |   | 4  |   | 3  |   | 2  |   | 1  |   |   |
| 3  |    |   |    |   |    |   |    |   |    |   |    |   |   |
| 4  | 7  |   | 8  |   | 9  |   | 10 |   | 11 |   | 12 |   |   |
| 5  |    |   |    |   |    |   |    |   |    |   |    |   |   |
| 6  | 18 |   | 17 |   | 16 |   | 15 |   | 14 |   | 13 |   |   |
| 7  |    |   |    |   |    |   |    |   |    |   |    |   |   |
| 8  | 19 |   | 20 |   | 21 |   | 22 |   | 23 |   | 24 |   |   |
| 9  |    |   |    |   |    |   |    |   |    |   |    |   |   |
| 10 | 30 |   | 29 |   | 28 |   | 27 |   | 26 |   | 25 |   |   |
| 11 |    |   |    |   |    |   |    |   |    |   |    |   |   |
| 12 | 31 |   | 32 |   | 33 |   | 34 |   | 35 |   | 36 |   |   |
| 13 |    |   |    |   |    |   |    |   |    |   |    |   |   |

**(C-6) 1/4 Corner Common to Sections 17 and 18, T51N, R40W**

A. Description of original monument and accessories and/or subsequent restoration:

1845 - William A. Burt, D.S., marked a 6" Black Ash for corner.  
 14" Yellow Birch N 67° W 24 links

1967 - R.S. Scott Engineering for L.P. Walsh Highway Construction Plans (on file at Ontonagon County Road Commission office) show a P.K. nail as P.I. and approximate 1/4 corner and 3 witnesses:  
 Telephone Pole N 50° E 30.33'  
 Fence Post N 80° W 89.3'  
 Fence Post S 80° W 82.2'

B. Description of corner evidence found and/or method applied in restoring or reestablishing corner:  
 I found no remains of original corner or accessories, or R.S. Scott corner and accessories.

At the corner position is North-South L.P. Walsh Road and a paved county road to the West. I accepted the intersection of centerlines of these two roads as the best position for the 1/4 corner, and monumented it with a P.K. nail and two reference monuments. Distances to North and South work reasonably well with R.S. Scott distances between stationing.

|                      |                 |          |                       |
|----------------------|-----------------|----------|-----------------------|
| NW Corner Section 17 | N 00° 29' 37" W | 2625.59' | (2626.50' R.S. Scott) |
| SW Corner Section 17 | S 00° 08' 57" E | 2639.43' | (2640.40' R.S. Scott) |

Research on file with County Remonumentation Representative.


C. Description of monument for corner and accessories established to perpetuate locating the position of the corner:

Corner is a P.K. nail in centerline of L.P. Walsh Rd., referenced by two monuments. The first reference monument (R.M. 1) was placed to the Northwest, a 2" x 30" aluminum pipe with a 3" diameter aluminum cap stamped to indicate that the 1/4 Corner is S 47° E 49.30 feet. The second monument (R.M. 2) is the same type, stamped to indicate that the 1/4 Corner is N 88° W 62.95 feet.

Witnesses:

|             |                 |        |
|-------------|-----------------|--------|
| R.M. 1      | N 46° 43' 24" W | 49.30' |
| 10" Poplar  | N 45° E         | 95.22' |
| R.M. 2      | S 88° 24' 25" E | 62.95' |
| Anchor Pole | S 59° E         | 75.88' |
| Power Pole  | S 64° W         | 80.95' |

PEER GROUP APPROVED  
*Carl W. [Signature]*  
 COUNTY REPRESENTATIVE 6-10-97

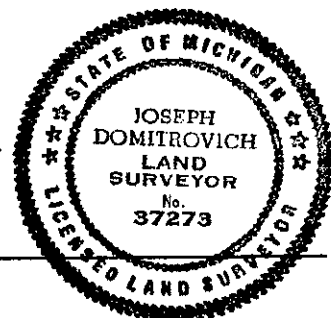

NOTE: Bearings are magnetic. Distances are to nail in side of witness objects unless noted.

Signed by J. C. Domitrovich

Date 6/9/97

Surveyor's Michigan License No. 37273