REMONUMENTATION
OCT 3 0 1997
COMMISSION

LAND CORNER RECORDATION CERTIFICATE
Filing Requirement of Act 74, Mich. P.A. 1970

For corners in

Ontonagon (County) Located In: Corner Code #

1. Public Land Survey		T 51N R 40W	C-7
		T___ R___	
		T___ R___	
		T___ R___	
2. Property Controlling	S___	T___ R___	
in Section	S___	T___ R___	
3. Miscellaneous	S___	T___ R___	
Property in Sec.	S___	T___ R___	

JUDITH D. ROEHM 07/18/97
Ontonagon County 11:28
LC 4/ 310 JJT Fee: 9.00
Page 1 of 1

Register of Deeds Stamp & File Number

4. Lot No. _____ , Recorded Plat _____
5. Private Claims _____

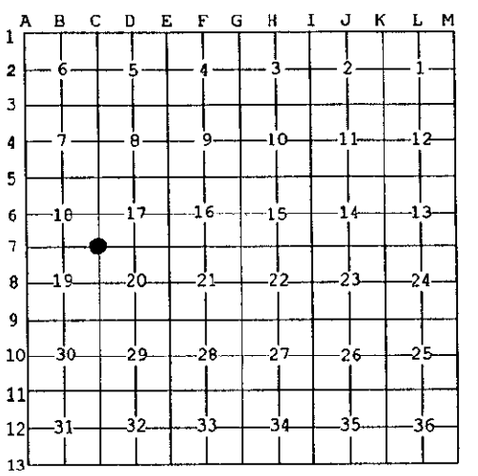

I, Joseph C. Domitrovich, in a field survey on June 11, 19 97 do hereby state that under requirements of P.A. 74, Michigan P.A. of 1970, the corner points mentioned in lines 1 and 2 above were in conformance with regulations and rules therefore as required in the current manual of survey instructions of the United States Department of the Interior, Bureau of Land Management or by a decree of a Court of Law and /or that the corner points mentioned in lines 3, 4 and 5 above were in conformance with the rules of the Michigan Board of Land Surveyors or by a Decree of a Court of Law; established, re-established, monumented, recovered, found as expressed below:

NOTE: Not more than 2 corners, all in the same town and range, may be recorded on this certificate.

(C-7) Corner of Sections 17, 18, 19, and 20, T51N, R40W

A. Description of original monument and accessories and/or subsequent restoration:

1845 - William A. Burt, D.S., set Fir post

14" Lynn	S 22° W	13 links
12" Maple	N 29° E	36 links

1967 - R.S. Scott Engineering (for L.P. Walsh Highway construction plans on file at Ontonagon County Road Commission office) show a P.K. nail for the P.I. and approximate section corner and 3 witnesses to it:

Telephone Pole	N 85° W	32.75'
6" Poplar	N 45° W	88.55'
6" Poplar	S 45° W	77.94'

B. Description of corner evidence found and/or method applied in restoring or reestablishing corner:

I found no remains of original corner or R.S. Scott corner or accessories. All have been obliterated due to construction of L.P. Walsh Highway. I accepted the intersection of the centerline of this highway and remains of old fence to East as the 1/4 Corner. This position works reasonably well with R.S. Scott distances (by stations) to the North and South:

E 1/4 Corner Sec. 19	S 00° 01' 27" W	2636.59'	(2637.55' R.S. Scott)
E 1/4 Corner Sec. 18	N 00° 08' 57" W	2639.43'	(2640.43' R.S. Scott)

Research on file with County Remonumentation Representative.

C. Description of monument for corner and accessories established to perpetuate locating the position of the corner:

Corner is a P.K. nail referenced by two monuments. The first reference monument (R.M. 1) was placed to the East, a 2" x 30" aluminum pipe with a 3" diameter aluminum cap stamped to indicate that the corner is N 89° W 61.25 feet. The second monument (R.M. 2), placed to the Southwest, is the same type, stamped to indicate that the corner is N 56° E 50.44 feet.

Witnesses:

R.M. 1	S 88° 34' 41" E	61.25'
8" Poplar	S 81° E	87.97'
R.M. 2	S 55° 59' 29" W	50.44'
Power Pole	N 65° W	77.28'

REER GROUP APPROVED
Earl W. Gulkamp
COUNTY REPRESENTATIVE
7-15-97

STATE OF MICHIGAN
JOSEPH DOMITROVICH
LAND SURVEYOR
No. 37273
LICENSED LAND SURVEYOR

NOTE: Bearings are magnetic. Distances are to nail in side of witness objects unless noted.

Signed by J. C. Domitrovich Date 7/15/97

Surveyor's Michigan License No. 37273

FORM APPROVED BY MICHIGAN STATE BOARD OF PROFESSIONAL SURVEYORS, JAN. 28, 1971
REVISED MAY 14,1975
REVISED JAN., 1983
REVISED OCT., 1995