


**LAND CORNER RECORDATION CERTIFICATE**  
**Filing Requirement of Act 74, Mich. P.A. 1970**

For corners in Ontonagon Located In: \_\_\_\_\_ Corner Code # \_\_\_\_\_  
(County)

1. Public Land Survey	T	<u>51N</u>	R	<u>40W</u>	<u>D-3</u>
	T	_____	R	_____	_____
	T	_____	R	_____	_____
	T	_____	R	_____	_____
2. Property Controlling in Section	S	_____	T	_____	R
	S	_____	T	_____	R
3. Miscellaneous Property in Section	S	_____	T	_____	R
	S	_____	T	_____	R

4. Lot No. \_\_\_\_\_, Recorded Plat \_\_\_\_\_  
 5. Private Claims \_\_\_\_\_

**SURVEY & REMONUMENTATION**  
 MAY 22 1997  
**COMMISSION**  
 Register of Deeds Stamp & File Number

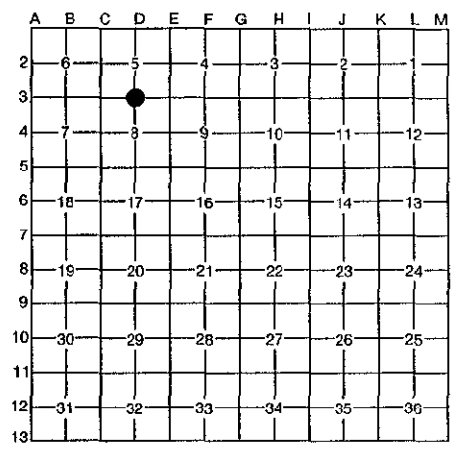

I, Joseph C. Domitrovich, in a field survey on September 30, 1996, do hereby certify that under requirements of P.A. 74, Michigan P.A. of 1970, the corner points mentioned in lines 1 and 2 above were in conformance with regulations and rules therefore as required in the current manual of survey instructions of the United States Department of the Interior, Bureau of Land Management or by a decree of a Court of Law and/or that the corner points mentioned in lines 3, 4 and 5 above were in conformance with the rules of the Michigan Board of Professional Surveyors or by a Decree of a Court of Law; established, re-established, monumented, re-monumented, recovered, found as expressed below:

**NOTE: Not more than 4 corners, all in the same town and range, may be recorded on this certificate.**

**A. Description of original monument and accessories and/or subsequent restoration:**

(D-3) 1/4 Corner Common to Sections 5 & 8. T51N R40W

- 1845 - William A. Burt set Hemlock post  
 20" Y. Birch N 47° E 31 links  
 18" Hemlock N 31° W 22 links

**B. Description of corner evidence found and/or method applied in restoring or reestablishing corner:**

Original corner and accessories have been obliterated by road construction. I found at the corner, the centerline of North-South "Quarterline" Road and remains of a very old fence running to East and West. I accepted the intersection of centerline and fencelines extended as the corner position. This works well with corners to East and West.

Research on file with County Remonumentation Representative.


**C. Description of monument for corner and accessories established to perpetuate locating the position of the corner:**

Corner is a 5/8" x 24" rebar with a 3" diameter aluminum cap stamped to read: 1/4; S. 5, S. 8; T.51N, R.40W; P.S. 37273; 1996; COUNTY REMONUMENTATION. I also established a reference monument (R.M.) to the West, a 2" x 30" aluminum pipe with a 3" diameter aluminum cap stamped to indicated that the corner is East 32.05'.

**Witnesses:**

- |                 |         |        |
|-----------------|---------|--------|
| 8" Poplar       | N 59° E | 56.57' |
| 7" Red Pine     | S 85° E | 42.33' |
| R.M.            | West    | 32.85' |
| Steel Sign Post | West    | 33.59' |
| 9" Soft Maple   | N50° W  | 58.04' |

**PEER GROUP APPROVED**  
*Earl W Applekamp*  
**COUNTY REPRESENTATIVE** 11-11-96

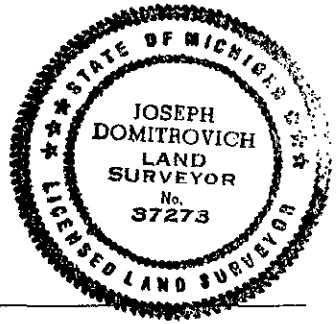

**NOTE: Bearings are magnetic. Distances are to nail in side of witness objects unless noted.**

Signed by Joseph C. Domitrovich Date 11/10/96

Surveyor's Michigan License No. 37273