

**LAND CORNER RECORDATION CERTIFICATE**

Filing Requirement of Act 74, Mich. P.A. 1970

For corners in Ontonagon Located In: \_\_\_\_\_ Corner Code # \_\_\_\_\_  
 (County)

- |                                      |   |            |   |            |            |       |
|--------------------------------------|---|------------|---|------------|------------|-------|
| 1. Public Land Survey                | T | <u>51N</u> | R | <u>40W</u> | <u>E-3</u> |       |
|                                      | T | _____      | R | _____      | _____      |       |
|                                      | T | _____      | R | _____      | _____      |       |
|                                      | T | _____      | R | _____      | _____      |       |
| 2. Property Controlling in Section   | S | _____      | T | _____      | R          | _____ |
|                                      | S | _____      | T | _____      | R          | _____ |
| 3. Miscellaneous Property in Section | S | _____      | T | _____      | R          | _____ |
|                                      | S | _____      | T | _____      | R          | _____ |


**SURVEY & REMONUMENTATION**

MAY 22 1997

**COMMISSION**

Register of Deeds Stamp & File Number

4. Lot No. \_\_\_\_\_, Recorded Plat \_\_\_\_\_  
 5. Private Claims \_\_\_\_\_

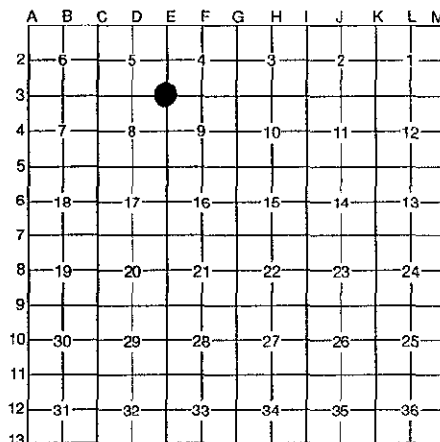

I, Joseph C. Domitrovich, in a field survey on September 12, 1996, do hereby certify that under requirements of P.A. 74, Michigan P.A. of 1970, the corner points mentioned in lines 1 and 2 above were in conformance with regulations and rules therefore as required in the current manual of survey instructions of the United States Department of the Interior, Bureau of Land Management or by a decree of a Court of Law and/or that the corner points mentioned in lines 3, 4 and 5 above were in conformance with the rules of the Michigan Board of Professional Surveyors or by a Decree of a Court of Law; established, re-established, monumented, re-monumented, recovered, found as expressed below:

**NOTE: Not more than 4 corners, all in the same town and range, may be recorded on this certificate.**

**A. Description of original monument and accessories and/or subsequent restoration:**

(E-3) Corner of Sections 4, 5, 8, & 9, T51N, R40W

1845 - William A. Burt set Hemlock post

- 12" Hemlock S 54° E 22 links
- 10" Y. Birch N 50° W 20 links

1980-81 - Robert Mick, P.S. 16936. Survey recorded in Liber 1 of Surveys, page 47, and corner recorded in Liber 2, page 6, of Corner Records. He found remains of a square stake and a small piece of rod or spike that fit well with REA pole line and center of road. He reset it with a 1/2" capped iron and established three witnesses. In his survey, he set a 1/2" capped iron 39.80' East of the corner and shows a distance (2639.63') North to 1/4 Corner.

**B. Description of corner evidence found and/or method applied in restoring or reestablishing corner:**

Original corner and accessories have been destroyed by farming, and road and powerline construction.

The Mick iron at the corner has been obliterated by road reconstruction. One bearing tree, a sawed-off powerpole, and the iron 39.80' East were recovered. I recreated his position for this corner from recovered objects.

This position works well with corners North, East, And West. I accepted this position as the Section Corner and monumented it as such.

Research on file with County Remonumentation Representative.

PEER GROUP APPROVED  
*Carl W Applecamp*  
 COUNTY REPRESENTATIVE  
 9-12-96

**C. Description of monument for corner and accessories established to perpetuate locating the position of the corner:**

Corner is a 5/8" x 24" iron with a 3" diameter aluminum cap stamped to read: S. 4, S. 5, S. 8, S. 9; T51N, R40W; 1996; P.S. 37273. Corner falls 5' West of present centerline of Wagner Road, on extension of powerline to East and 5.5' South of fenceline to the West. I also set a reference monument (R.M.), a 2" x 30" pipe with a 3" diameter aluminum cap stamped to indicate that the corner is East 26.31'.

**Witnesses:**

- 8" Poplar N 52° W 34.68'
- Power Pole N 57° E 49.82'
- 1/2" Capped Iron East 39.80' (#16936)
- 11" Poplar S 54° W 31.50' (Existing Nail)
- R.M. West 26.31'

**NOTE:** Bearings are magnetic. Distances are to nail in side of witness objects unless noted.

Signed by J. C. Domitrovich

Date 9/12/96

Surveyor's Michigan License No. 37273

