

**LAND CORNER RECORDATION CERTIFICATE**  
 Filing Requirement of Act 74, Mich. P.A. 1970

For corners in

<u>Ontonagon</u> (County)	Located In:	Corner Code #
1. Public Land Survey	T 51N R 40W	F-1
	T ___ R ___	_____
	T ___ R ___	_____
	T ___ R ___	_____
2. Property Controlling in Section	S ___ T ___ R ___	_____
	S ___ T ___ R ___	_____
3. Miscellaneous Property in Sec.	S ___ T ___ R ___	_____
	S ___ T ___ R ___	_____

**SURVEY & REMONUMENTATION**

MAY 22 1997

**COMMISSION**

Register of Deeds Stamp & File Number

4. Lot No. \_\_\_\_\_, Recorded Plat \_\_\_\_\_  
 5. Private Claims \_\_\_\_\_

I, Joseph C. Domitrovich, in a field survey on September 24, 1996 do hereby state that under requirements of P.A. 74, Michigan P.A. of 1970, the corner points mentioned in lines 1 and 2 above were in conformance with regulations and rules therefore as required in the current manual of survey instructions of the United States Department of the Interior, Bureau of Land Management or by a decree of a Court of Law and/or that the corner points mentioned in lines 3, 4 and 5 above were in conformance with the rules of the Michigan Board of Land Surveyors or by a Decree of a Court of Law; established, re-established, monumented, recovered, found as expressed below:

NOTE: Not more than 2 corners, all in the same town and range, may be recorded on this certificate.

**(F-1) North 1/4 Corner Section 4, T51N, R40W**

A. Description of original monument and accessories and/or subsequent restoration:

Corner was not set in original survey in 1845. William A. Burt set the South 1/4 corner to Section 33, T52N, R40'W but it would not be common to this corner because of closing corners on this twp. line.  
1957 - Victor A. Arcand R.L.S. 10678 calls for a drill steel at the South 1/4 corner of Section 33, T52N, R40W (Later determined to be N 1/4 corner Section 4) in survey for "Mary M. Craig Potato River property" partial copy at Ont. Co. Equalization.  
1969 - M.S.H.D. for M-64 Highway Plans call for a wood post. They called this corner common with 1/4 corner in Section 33 and show angle and a distance to it off of station 290+00.  
1972 - Earl Applekamp, P.S. 17610, found a 1" drill steel at this corner and established 3 witnesses.  
1984 - Robert Mick P.S. 16936 found this corner 2573.19' west of Standard Corner to east and called it common with 1/4 corner in Section 33.

B. Description of corner evidence found and/or method applied in restoring or reestablishing corner:

I recovered the drill steel called for by Applekamp and Arcand and the three witnesses called for by Applekamp. Angle and distance off of Station 290+00 to the drill steel match closely those recorded by the M.S.H.D. The distance east to the Standard corner measured 2572.75' which works well with Mick distance.  
 After extensive retracement in sections to the south I Determined that the drill steel was set at a mean bearing between the east and west lines of Section 4, and therefore is the North 1/4 corner of Section 4. I established 3 additional witnesses.

\*Note - This drill steel has been used in descriptions North and South of the Township line.

Research on file with County Remonumentation Representative.

**PEER GROUP APPROVED**  
*Earl W. Applekamp*  
 COUNTY REPRESENTATIVE

C. Description of monument for corner and accessories established to perpetuate locating the position of the corner:

Corner is a 2" x 30" aluminum pipe with a 3" diameter aluminum cap stamped to read: 1/4, c.c., S.4, T.51N., R.40W., 1996: P.S. 37273; COUNTY REMONUMENTATION. Corner falls 60' SE of centerline M-64,


**Witnesses:**

Power Pole	N 67° E	72.40' [Applekamp - 72.43 (R)]
1/2" Iron # 37273	S 89° E	8.88' (Property Corner)
Top Corner Steel Fence Post	S 50° E	91.13'
Top Corner Steel Fence Post	S 03° E	97.18' [Applekamp - 97.35' (R)]
Steel Sign Post	South	0.85'
8" Spruce	S 19° W	98.38'
Power Pole	S 56° W	122.20' [Applekamp - 122.22' (R)]

NOTE: Bearings are magnetic. Distances are to nail in side of witness objects unless noted.

Signed by Joseph C. Domitrovich  
 Surveyor's Michigan License No. 37273

Date 11/10/96

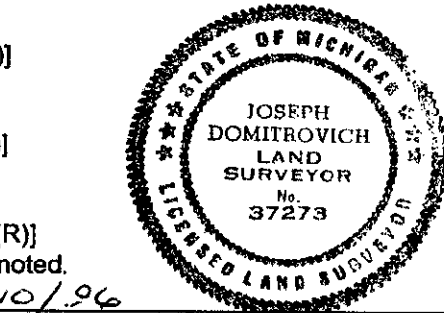

1	A	B	C	D	E	F	G	H	I	J	K	L	M
2		6		5		4		3		2		1	
3													
4		7		8		9		10		11		12	
5													
6		18		17		16		15		14		13	
7													
8		19		20		21		22		23		24	
9													
10		30		29		28		27		26		25	
11													
12		31		32		33		34		35		36	
13													