

LAND CORNER RECORDATION CERTIFICATE
Filing Requirement of Act 74, Mich. P.A. 1970

For corners in Ontonagon Located In: _____ Corner Code # _____
 (County)

1. Public Land Survey	T	51N	R40W	G-1
	T	_____	R_____	_____
	T	_____	R_____	_____
	T	_____	R_____	_____
2. Property Controlling in Section	S	_____	T_____	R_____
	S	_____	T_____	R_____
3. Miscellaneous Property in Section	S	_____	T_____	R_____
	S	_____	T_____	R_____

4. Lot No. _____, Recorded Plat _____
 5. Private Claims _____

SURVEY & REMONUMENTATION
 MAY 22 1997
COMMISSION
 Register of Deeds Stamp & File Number

A	B	C	D	E	F	G	H	I	J	K	L	M
2	6		5		4		3		2		1	
3												
4	7		8		9		10		11		12	
5												
6	18		17		16		15		14		13	
7												
8	19		20		21		22		23		24	
9												
10	30		29		28		27		26		25	
11												
12	31		32		33		34		35		36	
13												

I, Joseph C. Domitrovich, in a field survey on October 1, 19 96, do hereby certify that under requirements of P.A. 74, Michigan P.A. of 1970, the corner points mentioned in lines 1 and 2 above were in conformance with regulations and rules therefore as required in the current manual of survey instructions of the United States Department of the Interior, Bureau of Land Management or by a decree of a Court of Law and/or that the corner points mentioned in lines 3, 4 and 5 above were in conformance with the rules of the Michigan Board of Professional Surveyors or by a Decree of a Court of Law; established, re-established, monumented, re-monumented, recovered, found as expressed below:

NOTE: Not more than 4 corners, all in the same town and range, may be recorded on this certificate.

A. Description of original monument and accessories and/or subsequent restoration:

(G-1) Closing Corner Sections 3 & 4, T51N, R40W

1845 - William A. Burt intersected North boundary 66 links East of corner and set a Hemlock post
 16" Hemlock S 44° W 11 links
 8" Hemlock S 37° E 40 links

1928 - E.J. Donnelly, C.E., in Supervisor Carroll's Plat of Government Lots 3 & 4, T52N, R40W, shows this corner as common with sections in the township to North.

1969 - M.S.H.D. M-64 Highway plan found a star drill in concrete and called it a common corner as did Donnelly.

1979 - Robert Mick, P.S. 16936, in Ontonagon County Airport Survey on file with plats at the Ontonagon County Register of Deeds, found the star drill and determined that it was the Closing Corner for Sections 4 & 3, T51N, R40W and not a common corner.

B. Description of corner evidence found and/or method applied in restoring or reestablishing corner:

I found no remains of original corner or accessories. I found the 1 1/2" star drill in concrete as called for in previous surveys. After extensive retracement of sections to the South and along the township line, I came to the same conclusion as Bob Mick, that the concrete monument at the Southwest Corner of Supervisor Carroll's Plat is actually the Closing Corner for Sections 3 & 4, T51N, R40W. Measured distance East to creek crossing works well with GLO.

Research on file with County Remonumentation Representative.

PEER GROUP APPROVED
Earl W. Applekamp
 COUNTY REPRESENTATIVE 10-16-96


C. Description of monument for corner and accessories established to perpetuate locating the position of the corner:

Corner is a 2" x 5" section of aluminum pipe cemented on top of the star drill in concrete with a 3" diameter cap stamped to read: PLAT; S. 3, S. 4.; T.51N, R.40W; 1996; C.C.; P.S. 37273; COUNTY REMONUMENTATION. Corner falls 36' East of North-South woods road.

Witnesses:

6" Hemlock	N 25° E	30.56'	
5" Twin Soft Maple	S 50° E	16.67'	
7" Soft Maple	S 07° E	6.28'	
Standard Corner	West	43.56'	(Corner of Sections 33 & 34, T52N, R40W)
12" W. Birch	N 02° W	22.16'	(Existing Blaze)
Steel Sign Post	N 17° E	1.34'	

NOTE: Bearings are magnetic. Distances are to nail in side of witness objects unless noted.

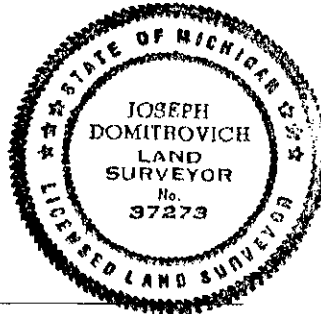

Signed by Joseph C. Domitrovich Date 10/15/96

Surveyor's Michigan License No. 37273