

**LAND CORNER RECORDATION CERTIFICATE**  
**Filing Requirement of Act 74, Mich. P.A. 1970,**  
**Ontonagon County Remonumentation Corner**

ROEHN 1F  
 Ontonagon County  
 Page 1 of 1 LC 5/ 67  
 JDR Rec. Date 05/26/98 Time 10:47  
 RECORDING FEE: 9.00

For corners in

Ontonagon County	Located in:	Corner Code #
1. Public Land Survey	T51N R40W	G-5
	T R	
	T R	
	T R	
2. Property Controlling in Section	S T R	
	S T R	
3. Miscellaneous Property in Sec.	S T R	
	S T R	
4. Lot No. , Recorded Plat		
5. Private Claims		

SURVEY &  
 REMONUMENTATION

JAN 11 1999

Register of Deeds Stamp & File Number

	A	B	C	D	E	F	G	H	I	J	K	L	M
1													
2	6	5	4	3	2	1							
3													
4	7	8	9	10	11	12							
5													
6	18	17	16	15	14	13							
7													
8	19	20	21	22	23	24							
9													
10	30	29	28	27	26	25							
11													
12	31	32	33	34	35	36							
13													

I, Joseph C. Domitrovich, in a field survey on May 8, 1998, do hereby state that under requirements of P.A. 74, Michigan P.A. of 1970, the corner points mentioned in lines 1 and 2 above were in conformance with regulations and rules therefore as required in the current manual of survey instructions of the United States Department of the Interior, Bureau of Land Management or by a decree of a Court of Law and for that the corner points mentioned in lines 3, 4 and 5 above were in conformance with the rules of the Michigan Board of Land Surveyors or by a Decree of a Court of Law; established, re-established, monumented, recovered, found as expressed below:

NOTE: Not more than 2 corners, all in the same town and range, may be recorded on this certificate.

A. Description of original monument and accessories and/or subsequent restoration:

(G-5) Corner of Sections 9,10,15 and 16, T51N, R40W

1845 - William A. Burt set an Ironwood Post: 14" Sugar S50°W 36 links  
 24" Hemlock N43°E 50 links

1928 - Earl J. Donnelly, C.E., for Supervisor Carroll's Plat of Gov't Lots 3 & 4, Section 34, T52N, R40W, shows this corner as being a stake 5277.2' South of the SW Corner of Section 3, T51N, R40W.

B. Description of corner evidence found and/or method applied in restoring or reestablishing corner:

I found no remains of the original corner or accessories. Area around corner has been heavily logged.

I reestablished corner position by proportionate measurement between the West ¼ Corner of Section 10 to the North, the Southwest corner of Section 15 to the South, and definite stream calls to the East and West. This works well with GLO distances to corners to North, South and West. This position falls 9' East of a 5" maple with an aluminum "Champion" tag from 1978. This corner falls 5268.30' South of the SW Corner of Section 3 to the North. (5277.2' Donnelly)

Research on file with County Remonumentation Representative.


C. Description of monument for corner and accessories established to perpetuate locating the position of the corner:

Corner is a 2" X 30" aluminum pipe with a 3" diameter aluminum cap stamped to read: COUNTY REMONUMENTATION; T51N, R40W; S.9, S.10, S.15, S.16; 1998; P.S. 37273. Corner falls 50' west of a North-South Logging Road.

Witnesses:

4" Soft Maple	N23°E	11.17'	
5" Hard Maple	S42°E	6.80'	
8" Hard Maple	S41°W	16.12'	
5" Hard Maple	S82°W	9.09'	(Champion tag on South side of Tree)
Steel Sign Post	West	0.89'	
W¼ Cor. Sec. 10	N00°20'52"W	2640.04'	(2640 GLO)
SW Cor. Sec. 10	S00°14'46"E	5280.08'	(5280 GLO)
S¼ Cor. Sec. 9	N89°40'48"W	2648.07'	(2644.62 GLO)

PEER GROUP APPROVED 5-13-98  
*Earl W. Applekamp*  
 COUNTY SURVEYOR

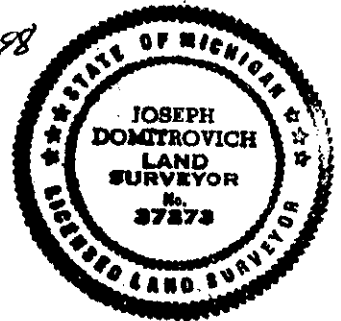

NOTE: Bearings to witness objects are magnetic. Distances are to a nail in side of the witness object unless noted.

Signed by Joseph C. Domitrovich Date 5/13/98

Surveyor's Michigan License No. 37273