

JUDITH D. POEHN 1P
LAND CORNER RECORDATION CERTIFICATE Ontonagon County
Filing Requirement of Act 74, Mich. P.A. 1970 of 1 LC 5/ 69
Ontonagon County Remonumentation Corner Rec. Date 05/26/98 Time 10:48

RECORDING FEE: 9.00

For corners in

Ontonagon County Located in: Corner Code #

1. Public Land Survey T51N R40W G-8
T R
T R
T R
T R
T R
T R

2. Property Controlling S T R
in Section S T R
3. Miscellaneous S T R
Property in Sec. S T R

4. Lot No. , Recorded Plat
5. Private Claims

SURVEY &
REMONUMENTATION

JAN 11 1999

SECTION

Register of Deeds Stamp & File Number

	A	B	C	D	E	F	G	H	I	J	K	L	M
1													
2	6	5	4	3	2	1							
3													
4	7	8	9	10	11	12							
5													
6	18	17	16	15	14	13							
7													
8	19	20	21	22	23	24							
9													
10	30	29	28	27	26	25							
11													
12	31	32	33	34	35	36							
13													

I, Joseph C. Domitrovich, in a field survey on May 13, 1998, do hereby state that under requirements of P.A. 74, Michigan P.A. of 1970, the corner points mentioned in lines 1 and 2 above were in conformance with regulations and rules therefore as required in the current manual of survey instructions of the United States Department of the Interior, Bureau of Land Management or by a decree of a Court of Law and for that the corner points mentioned in lines 3, 4 and 5 above were in conformance with the rules of the Michigan Board of Land Surveyors or by a Decree of a Court of Law; established, re-established, monumented, recovered, found as expressed below:

NOTE: Not more than 2 corners, all in the same town and range, may be recorded on this certificate.

A. Description of original monument and accessories and/or subsequent restoration:
(G-8) ¼ Corner of Sections 21 & 22, T51N, R40W

1845 - William A. Burt set a fir post.
24" Lynn N 44° E 17 links
14" Hemlock N 13° W 20 links

I found no record of subsequent restoration.

B. Description of corner evidence found and/or method applied in restoring or reestablishing corner:

I found no remains of original corner or accessories.

I found a bent aluminum pipe at the corner. 34.4 feet to the North of this pipe is a dead poplar with a 1978 Champion tag indicating: "34" S. to ¼ Corner." This pipe falls 29.5 feet North of the intersection of old fences South and East.

This pipe is within 0.22 feet of being midway between Section Corners to North and South and falls on line with old fence to South. I accepted the aluminum pipe as the ¼ Corner and replaced it with a County Monument.

Research on file with County Remonumentation Representative.

C. Description of monument for corner and accessories established to perpetuate locating the position of the corner:


Corner is a 2 ½" x 30" aluminum pipe with a 3" diameter aluminum cap stamped to read: COUNTY REMONUMENTATION; T51N, R40W; S. 21, S. 22; ¼; 1998; P.S. 37273.

Witnesses:

7" Poplar	N 40° E	14.51'
6" Spruce	S 28° E	37.38'
8" Poplar	S 05° W	32.50'
3" Soft Maple	S 60° W	8.03'
Steel Sign Post	North	1.13' (to face)
NW Cor. Sec. 22	N 00° 12' 25" W	2628.61'
SW Cor. Sec. 22	S 00° 03' 53" E	2629.05'

PEER GROUP APPROVAL

Paul W. Applekamp
COUNTY REMONUMENTATION
5-13-98

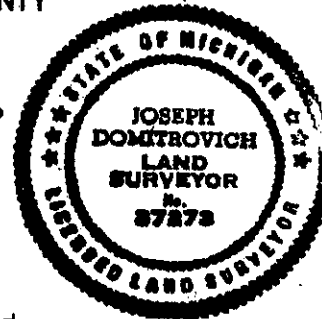

NOTE: Bearings are magnetic. Distances are to a nail in side of the witness object unless noted.

Signed by J. C. Domitrovich

Date 5/13/98

Surveyor's Michigan License No. 37273