

JUDITH D. ROEHM 1P
LAND CORNER RECORDATION CERTIFICATE Ontonagon County
 Filing Requirement of Act 74, Mich. P.A. 1970 of 1 LC 5/ 70
 Ontonagon County Remonumentation Corner Rec. Date 05/26/98 Time 10:48

RECORDING FEE: 9.00

For corners in

Ontonagon County	Located in:	Corner Code #
1. Public Land Survey	T51N R40W	G-9
	T R	
	T R	
	T R	
2. Property Controlling in Section	S T R	
	S T R	
3. Miscellaneous Property in Sec.	S T R	
	S T R	

SURVEY & REMONUMENTATION

JAN 11 1999

Register of Deeds Stamp & File Number

4. Lot No. , Recorded Plat
 5. Private Claims

SECTION

I, Joseph C. Domitrovich, in a field survey on May 13, 1998, do hereby state that under requirements of P.A. 74, Michigan P.A. of 1970, the corner points mentioned in lines 1 and 2 above were in conformance with regulations and rules therefore as required in the current manual of survey instructions of the United States Department of the Interior, Bureau of Land Management or by a decree of a Court of Law and for that the corner points mentioned in lines 3, 4 and 5 above were in conformance with the rules of the Michigan Board of Land Surveyors or by a Decree of a Court of Law; established, re-established, monumented, recovered, found as expressed below:

NOTE: Not more than 2 corners, all in the same town and range, may be recorded on this certificate.

	A	B	C	D	E	F	G	H	I	J	K	L	M
1													
2	6	5	4	3	2	1							
3													
4	7	8	9	10	11	12							
5													
6	18	17	16	15	14	13							
7													
8	19	20	21	22	23	24							
9													
10	30	29	28	27	26	25							
11													
12	31	32	33	34	35	36							
13													

A. Description of original monument and accessories and/or subsequent restoration:
(G-9) Corner of Sections 21, 22, 27 & 28, T51N, R40W

1845 - William A. Burt set an Ironwood post: 12° Y. Birch S 81° E 27 links
 8° Maple N 45° W 13 links

I found no record of subsequent restoration.

B. Description of corner evidence found and/or method applied in restoring or reestablishing corner:

I found no remains of original corner or accessories. Area around corner has been farmed for over 70 years.

At the corner now, is an East-West gravel (clay) county road (Stimac Road) and an old fenceline to the North and South. Joseph Stimac, a resident of the area for over 60 years, stated that this corner was in dispute in the 1940's. The county Surveyor at that time reestablished the corner. Mr. Stimac showed me where the corner had been set. It has since been graded out. I reestablished the corner at the position shown to me by Mr. Stimac. It fell in the centerline of the county road and on line with fences to the North and South.

Research on file with County Remonumentation Representative.

C. Description of monument for corner and accessories established to perpetuate locating the position of the corner:

Corner is a 5/8" x 24" rebar with a 3" diameter aluminum cap stamped to read: COUNTY REMONUMENTATION; T51N, R40W; S. 21, S. 22, S. 27, S. 28; 1998; P.S. 37273. I established a reference monument, R.M., to the North, a 2 1/2" x 30" aluminum pipe with a 3" diameter aluminum cap stamped to indicate that the corner is 31.49 feet to the South. I also placed a steel sign post 1.04' North of the R.M.


Witnesses:

6" Twin Apple Tree	N 22° E	37.14'	
1" Iron Bolt	South	34.15'	(falls 1' South of fence corner)
8" Twin Apple Tree	S 12° W	34.48'	
10" Elm	S 65° W	74.87'	
R.M.	N 02° 37' 20" E	31.49'	(falls 1.5' South and 1.5' East of fence corner)
W 1/4 Cor. Sec. 22	N00° 03' 53" W	2629.05'	(2640.0' GLO)
S 1/4 Cor. Sec. 22	S 89° 55' 09" E	2635.34'	(2632.74' GLO)

NOTE: Bearings to witness objects are magnetic. Distances are to a nail in side of the witness object unless noted.

Signed by Joseph C. Domitrovich

Surveyor's Michigan License No. 37273

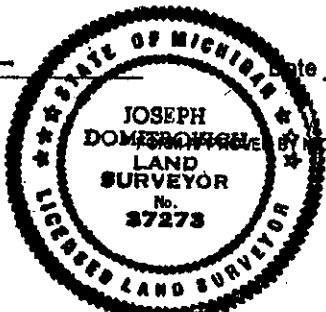

PEER GROUP APPROVAL
Paul W. Cookcamp 5-13-98
 COUNTY Alcona
 Date 5/13/98