

LAND CORNER RECORDATION CERTIFICATE
Filing Requirement of Act 74, Mich. P.A. 1970

For corners in Ontonagon Located In: _____ Corner Code # _____
 (County)

- | | | | | | |
|--------------------------------------|---|-------|---|-------|-------|
| 1. Public Land Survey | T | 51N | R | 40W | H-3 |
| | T | _____ | R | _____ | _____ |
| | T | _____ | R | _____ | _____ |
| | T | _____ | R | _____ | _____ |
| 2. Property Controlling in Section | S | _____ | T | _____ | R |
| | S | _____ | T | _____ | R |
| 3. Miscellaneous Property in Section | S | _____ | T | _____ | R |
| | S | _____ | T | _____ | R |
4. Lot No. _____, Recorded Plat _____
 5. Private Claims _____

SURVEY & REMONUMENTATION
 MAY 22 1997
COMMISSION

Register of Deeds Stamp & File Number

A	B	C	D	E	F	G	H	I	J	K	L	M
2	6		5		4		3		2		1	
3							●					
4	7		8		9		10		11		12	
5												
6	18		17		16		15		14		13	
7												
8	19		20		21		22		23		24	
9												
10	30		29		28		27		26		25	
11												
12	31		32		33		34		35		36	
13												

I, Joseph C. Domitrovich, in a field survey on August 30, 1996, do hereby certify that under requirements of P.A. 74, Michigan P.A. of 1970, the corner points mentioned in lines 1 and 2 above were in conformance with regulations and rules therefore as required in the current manual of survey instructions of the United States Department of the Interior, Bureau of Land Management or by a decree of a Court of Law and/or that the corner points mentioned in lines 3, 4 and 5 above were in conformance with the rules of the Michigan Board of Professional Surveyors or by a Decree of a Court of Law; established, re-established, monumented, re-monumented, recovered, found as expressed below:

NOTE: Not more than 4 corners, all in the same town and range, may be recorded on this certificate.

A. Description of original monument and accessories and/or subsequent restoration:

(H-3) 1/4 Corner Sections 3 & 10, T51N, R40W

1845 - William A. Burt set Hemlock post
 12" Hemlock N 61° E 40 links
 10" Cedar N 64° W 14 links

1979 - Robert Mick, P.S. 16936, on Ontonagon County Airport survey map on file with Plats at Ontonagon Co. Register of Deeds, notes that he set a concrete monument at this corner by single proportionate measurement and established 2 witnesses.

B. Description of corner evidence found and/or method applied in restoring or reestablishing corner:

Original Corner and accessories have been destroyed by logging and road clearing.

I found a 1/2" iron encased in a 6" diameter concrete monument and Bob Mick's 2 witnesses. Monument falls on line with an east-west powerline and falls 44' west and 10' north of a Champion Intl. wood post and corner tag (set in 1995)

This concrete monument works well with other corners in area. I accepted it as the 1/4 corner and placed a 2" diameter aluminum cap on it.

Research on file with County Remonumentation Representative.


C. Description of monument for corner and accessories established to perpetuate locating the position of the corner:

Corner is a 1/2" iron encased in a 6" diameter concrete monument with a 2" diameter aluminum cap stamped to read: 1/4 S.3, S.10; T.51N., R.40W.; 1996; P.S. 37273. Corner falls 10' north of an east-west fence, 10' south of centerline of a dirt road, and 108' west of a North-South creek crossing.

Witnesses:

11" Balsam	N 35° W	41.00' (Existing)
7" Balsam	N 25° E	50.80'
Power Pole	East	28.00 (Existing)
6" Soft Maple	South	28.40'
Steel Sign Post	West	0.98'

PEER GROUP APPROVED
Earl W. Applekamp
 COUNTY REPRESENTATIVE
 9-12-96

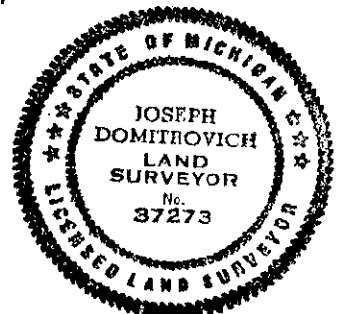

NOTE: Bearings are magnetic. Distances are to nail in side of witness objects unless noted.

Signed by Joseph C. Domitrovich Date 9/12/96
 Surveyor's Michigan License No. 37273