For corners in	LAND CORNER RECORDATION CERTIFICATED. FOEHM Filing Requirement of Act 74, Mich. P.A. 1970 Uniteration County Ontonagon County Remonumentation Corporation 1 LC 57			
Ontonagon County	Located in:		Corner Code #	JEM Rec. Date 06/25/99 Time 12:10 RECOMBING/FEE: 9.00
Public Land Survey	T51N T T	R40W R R R	H-5	P.T. 6.7000E.N. JAN 20N
 Property Controlling in Section Miscellaneous Property in Sec. 	S T S T S T	R R R R		
. ,	~ ,	11		Register of Deads Storm & File Number

Α В c

б

ø

9

10

11 12


4. Lot No.

, Recorded Plat

5. Private Claims

I, Joseph C. Domitrovich, in a field survey on June 15, 1998, do hereby state that under requirements of P.A. 74, Michigan P.A. of 1970, the corner points mentioned in lines 1 and 2 above were in conformance with regulations and rules therefore as required in the current manual of survey instructions of the United States Department of the Interior, Bureau of Land Management or by a decree of a Court of Law and for that the corner points mentioned in lines 3, 4 and 5 above were in conformance with the rules of the Michigan Board of Land Surveyors or by a Decree of a Court of Law; established, re-established, monumented, recovered, found as expressed below:

NOTE: Not more than 2 corners, all in the same town and range, may be recorded on this certificate.

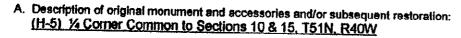

1845 - William A. Burt set Maple post

20" Hemlock

N 35° E

23 links

16" Y. Birch

N 55° W

35 links

No subsequent record found.

B. Description of corner evidence found and/or method applied in restoring or reestablishing corner:

I found no remains of the original corner or accessories. The area around the corner has been heavily logged. I found no other evidence of the corner position. Therefore, I re-established it by single proportionate measurement.

Distances to the corners East and West work well with original GLO distances.

Research on file with County Remonumentation Representative.

C. Description of monument for comer and accessories established to perpetuate locating the position of the corner:

Corner is a 2 ½" x 30" aluminum pipe with a 3" diameter aluminum cap stamped to read: COUNTY REMONUMENTATION; S.10, S.15; T.51N, R.40W; 14; 1998; P.S. 37273.

Witnesses:

8" Soft Maple N 82° W 33.76 B* Soft Maple N 16° W 11.23 7" Soft Maple N 79° E 17.06 6" Ash S 53° E 9.861 Steel Sign Post South 0.94'(to face) SW Cor. Section 10 N 89° 53' 53" W 2634.311 (2634.72)GLO) SE Cor. Section 10 S 89° 53' 53" E 2634.311 (2634.72)GLO)

0 F #164/2 JOSEPH DOMITROVICH LAND CANDS

NOTE: Bearings to witness objects are magnetic. Distances are to a nail in side of the witness object unless noted.

6-17-98