

**LAND CORNER RECORDATION CERTIFICATE**  
**Filing Requirement of Act 74, Mich. P.A. 1970**  
**Ontonagon County Remonumentation Corner**

JDF Rec. Date 05/25/98 Time 10:40  
 RECORDING FEE: 9.00

For corners in

Ontonagon County Located in: Corner Code #

1. Public Land Survey T51N R40W H-7  
 T R  
 T R  
 T R

2. Property Controlling S T R  
 in Section S T R  
 3. Miscellaneous S T R  
 Property in Sec. S T R

4. Lot No. , Recorded Plat  
 5. Private Claims SECTION

SURVEY &  
 REMONUMENTATION

JAN 11 1999

Register of Deeds Stamp & File Number

A	B	C	D	E	F	G	H	I	J	K	L	M
1												
2	6	5	4	3	2	1						
3												
4	7	8	9	10	11	12						
5												
6	18	17	16	15	14	13						
7												
8	19	20	21	22	23	24						
9												
10	30	29	28	27	26	25						
11												
12	31	32	33	34	35	36						
13												

I, Joseph C. Domitrovich, in a field survey on May 13, 1998, do hereby state that under requirements of P.A. 74, Michigan P.A. of 1970, the corner points mentioned in lines 1 and 2 above were in conformance with regulations and rules therefore as required in the current manual of survey instructions of the United States Department of the Interior, Bureau of Land Management or by a decree of a Court of Law and /or that the corner points mentioned in lines 3, 4 and 5 above were in conformance with the rules of the Michigan Board of Land Surveyors or by a Decree of a Court of Law; established, re-established, monumented, recovered, found as expressed below:

NOTE: Not more than 2 corners, all in the same town and range, may be recorded on this certificate.

A. Description of original monument and accessories and/or subsequent restoration:  
(H-7) ¼ Corner Common to Sections 15 & 22, T51N, R40W

1845 - William A. Burt set a Hemlock post  
 20" Hemlock N 18° E 25 links  
 12" Sugar N 46° W 20 links

I found no record of subsequent restoration.

B. Description of corner evidence found and/or method applied in restoring or reestablishing corner:

I found rotted remains of the Hemlock B.T., now a 36" rotted mass.

At the corner, I found the hole left by a rotten wood post and an aluminum Champion tag on a dead 5" Maple facing it. Tag indicates that the corner is N 17° W 12 links. Distances from the hole to the remains of the rotten Hemlock B.T. stump and to the Champion tag work well. I placed a County Monument at this position.

Research on file with County Remonumentation Representative.

C. Description of monument for corner and accessories established to perpetuate locating the position of the corner:


Corner is a 2 ½" x 30" aluminum pipe with a 3" diameter aluminum cap stamped to read: COUNTY REMONUMENTATION; S. 15, S. 22; ¼; T.51N, R.40W; P.S. 37273.

Witnesses:  
 4" Poplar N 58° E 12.81'  
 4" Poplar S 45° E 8.25'  
 5" Maple (dead) S 16° E 8.00' (Champion tag on it)  
 3" Soft Maple S 25° W 3.65'  
 Steel Sign Post North 0.97'

SW Cor. Sec. 15 S 89° 56' 13" W 2626.12' (2636.7' GLO)  
 SE Cor. Sec. 15 S 89° 56' 41" E 2627.48' (2636.7' GLO)

NOTE: Bearings to witness objects are magnetic. Distances are to a nail in side of the witness object unless noted.

PEER GROUP APPROVED  
*Earl W. Applekamp*  
 COUNTY REMONUMENTATION 5-13-98

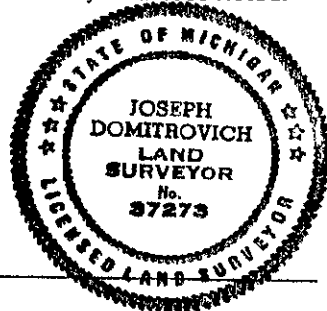

Signed by J. C. Domitrovich  
 Surveyor's Michigan License No. 37273

Date 5/13/98