

LAND CORNER RECORDATION CERTIFICATE
 Filing Requirement of Act 74, Mich. P.A. 1970

For corners in Ontonagon Located In: _____ Corner Code # _____
 (County)

1. Public Land Survey	T	51N	R	40W	J-1
	T	_____	R	_____	_____
	T	_____	R	_____	_____
	T	_____	R	_____	_____
2. Property Controlling in Section	S	_____	T	_____	R
	S	_____	T	_____	R
3. Miscellaneous Property in Section	S	_____	T	_____	R
	S	_____	T	_____	R

4. Lot No. _____, Recorded Plat _____
 5. Private Claims _____

SURVEY & REMONUMENTATION
 MAY 22 1997
COMMISSION
 Register of Deeds Stamp & File Number

A	B	C	D	E	F	G	H	I	J	K	L	M
2	6	5	4	3	2	1						
3												
4	7	8	9	10	11	12						
5												
6	18	17	16	15	14	13						
7												
8	19	20	21	22	23	24						
9												
10	30	29	28	27	26	25						
11												
12	31	32	33	34	35	36						
13												

I, Joseph C. Domitrovich, in a field survey on September 3, 19____, do hereby certify that under requirements of P.A. 74, Michigan P.A. of 1970, the corner points mentioned in lines 1 and 2 above were in conformance with regulations and rules therefore as required in the current manual of survey instructions of the United States Department of the Interior, Bureau of Land Management or by a decree of a Court of Law and/or that the corner points mentioned in lines 3, 4 and 5 above were in conformance with the rules of the Michigan Board of Professional Surveyors or by a Decree of a Court of Law; established, re-established, monumented, re-monumented, recovered, found as expressed below:

NOTE: Not more than 4 corners, all in the same town and range, may be recorded on this certificate.

A. Description of original monument and accessories and/or subsequent restoration:
(J-1) North 1/4 Corner Section 2, T51N, R40W

This corner was not set in the original survey.

1923 - E.J. Donnelly C.E., in map on file at Ontonagon County Abstract and Title, mistakenly shows this corner as being common with the S 1/4 corner of Section 35, T52N, R40W.

B. Description of corner evidence found and/or method applied in restoring or reestablishing corner:
 I established this corner midway between closing corners to the east and west, on line between the S 1/4 Corner Section 35, T52N, R40W. and the standard corner Sections 35 and 36, T52N, R40W.

This corner falls 14.65' east of the S 1/4 corner Section 35, T52N, R40W.


Research on file with County Remonumentation Representative.

C. Description of monument for corner and accessories established to perpetuate locating the position of the corner:
 Corner is a 5/8" x 24" rebar with a 3" diameter aluminum cap stamped to read: 1/4 S.2; C.C.; T.51N., R.40W.; 1996; P.S. 37273, and falls in the East gravel shoulder 14.6' East of centerline Norwich Road. I also set a Reference Monument (R.M.), a 2" x 30" aluminum pipe with a 3" aluminum cap stamped to indicate that the corner is west 15.34'.

Witnesses:

South 1/4 Corner Section 35, T52N, R40W	West	14.65'
Twin 8" Birch	N 64° W	71.20'
7" Balsam	N 48° W	69.61'
Triple 7" Maple	N 28° E	49.10'
R.M.	East	15.34'
9" Poplar	S 40° E	41.62'

PEER GROUP APPROVED
Earl W. Applekamp
 COUNTY REPRESENTATIVE
 9-12-96

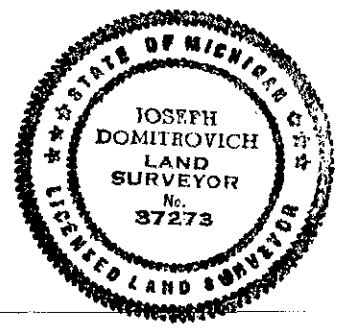

NOTE: Bearings are magnetic. Distances are to nail in side of witness objects unless noted.

Signed by J. C. Domitrovich Date 9/12/96
 Surveyor's Michigan License No. 37273