

LAND CORNER RECORDATION CERTIFICATE
Filing Requirement of Act 74, Mich. P.A. 1970

For corners in Ontonagon Located In: _____ Corner Code # _____
 (County)

- | | | | | |
|--------------------------------------|---|-------|------|-------|
| 1. Public Land Survey | T | 51N | R40W | J-3 |
| | T | _____ | R | _____ |
| | T | _____ | R | _____ |
| | T | _____ | R | _____ |
| 2. Property Controlling in Section | S | _____ | T | _____ |
| | S | _____ | T | _____ |
| 3. Miscellaneous Property in Section | S | _____ | T | _____ |
| | S | _____ | T | _____ |

SURVEY & REMONUMENTATION
MAY 22 1997
COMMISSION
 Register of Deeds Stamp & File Number

4. Lot No. _____, Recorded Plat _____
 5. Private Claims _____


I, Joseph C. Domitrovich, in a field survey on August 29, 19 96, do hereby certify that under requirements of P.A. 74, Michigan P.A. of 1970, the corner points mentioned in lines 1 and 2 above were in conformance with regulations and rules therefore as required in the current manual of survey instructions of the United States Department of the Interior, Bureau of Land Management or by a decree of a Court of Law and/or that the corner points mentioned in lines 3, 4 and 5 above were in conformance with the rules of the Michigan Board of Professional Surveyors or by a Decree of a Court of Law; established, re-established, monumented, re-monumented, recovered, found as expressed below:

NOTE: Not more than 4 corners, all in the same town and range, may be recorded on this certificate.

A. Description of original monument and accessories and/or subsequent restoration:

(J-3) 1/4 Corner Sections 2 & 11, T51N, R40W

- 1845 - William A. Burt set Y. Birch Post
 14" Hemlock N 58° E 31 links
 18" Hemlock N 38° E 30 links

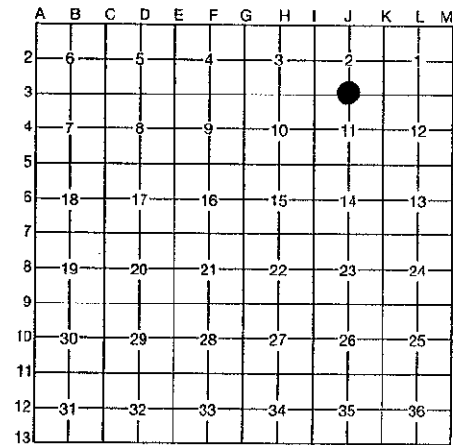

B. Description of corner evidence found and/or method applied in restoring or reestablishing corner:

Corner position falls in 3-way intersection and all remains of original corner and accessories have been destroyed. The 1/16 corner to the east of this corner is a 1" pipe and has been long accepted by local residents. A position for this 1/4 corner was created on line with the 1/16 corner (pipe) and Section corner to the east, at double the distance between the 1/16 corner and Section corner. This position works well for line and distance with Section corner to east. It falls on centerline road to west and 6' east of centerline North-South Norwich Road. (Norwich Road is not straight at this point.) I accepted this position as the best location of the 1/4 corner and have monumented it as such.

Research on file with County Remonumentation Representative.


C. Description of monument for corner and accessories established to perpetuate locating the position of the corner:

Corner is a 5/8" x 24" rebar with a 3" diameter aluminum cap stamped to read: 1/4 S.2. S.11; T.51N., R.40W.; 1996; P.S. 37273, set in paved road 6' East of centerline Norwich Road on Centerline paved road to west. I also set a 2" x 30" aluminum pipe as a reference monument (R. M.), with a 3" stamped aluminum cap indicating that the corner is S 42° E, 52.59'

Witnesses:

- | | | |
|---------------|---------|--------|
| 7" Twin Apple | N 33° E | 26.08' |
| Power Pole | S 42° E | 37.44' |
| 5" Hard Maple | S 34° W | 67.50' |
| R.M. | N 42° W | 52.59' |

PEER GROUP APPROVED
Earl W. Applekamp
 COUNTY REPRESENTATIVE
 8-12-96

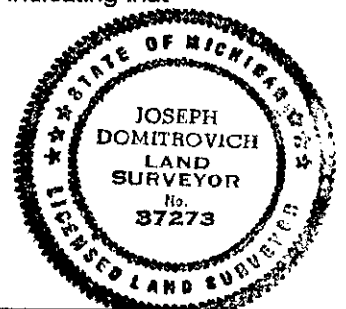

NOTE: Bearings are magnetic. Distances are to nail in side of witness objects unless noted.

Signed by Joseph C. Domitrovich

Date 9/12/96

Surveyor's Michigan License No. 37273