

LAND CORNER RECORDATION CERTIFICATE
Filing Requirement of Act 74, Mich. P.A. 1970
Ontonagon County Remonumentation Corner

WALTER D. ROEHM
 Ontonagon County
 Page 1 of 1 LC 5/194
 JJJ Rec. Date 06/15/99 Time 13:29
 RECORDING FEE: 9.00

For corners in

Ontonagon County	Located in:	Corner Code #
1. Public Land Survey	T51N R40W	J-5
	T R	
	T R	
	T R	
2. Property Controlling in Section	S T R	
	S T R	
3. Miscellaneous Property in Sec.	S T R	
	S T R	
4. Lot No. , Recorded Plat		
5. Private Claims		

**SURVEY &
 REMONUMENTATION**

MAR 23 2000

SECTION
 Register of Deeds Stamp & File Number

	A	B	C	D	E	F	G	H	I	J	K	L	M
1													
2	6	5	4	3	2	1							
3													
4	7	8	9	10	11	12							
5													
6	18	17	16	15	14	13							
7													
8	19	20	21	22	23	24							
9													
10	30	29	28	27	26	25							
11													
12	31	32	33	34	35	36							
13													

I, Joseph C. Domitrovich, in a field survey on June 8, 1999, do hereby state that under requirements of P.A. 74, Michigan P.A. of 1970, the corner points mentioned in lines 1 and 2 above were in conformance with regulations and rules therefore as required in the current manual of survey instructions of the United States Department of the Interior, Bureau of Land Management or by a decree of a Court of Law and for that the corner points mentioned in lines 3, 4 and 5 above were in conformance with the rules of the Michigan Board of Land Surveyors or by a Decree of a Court of Law; established, re-established, monumented, recovered, found as expressed below:

NOTE: Not more than 2 corners, all in the same town and range, may be recorded on this certificate.

A. Description of original monument and accessories and/or subsequent restoration:

(J-5) ¼ CORNER COMMON TO SECTIONS 11 & 14, T51N, R40W.

1845 - William A. Burt set a Hemlock Post

12"	Hemlock	N72°E	31 links
18"	Yellow Birch	N68°W	49 links

B. Description of corner evidence found and/or method applied in restoring or reestablishing corner:

I found no remains of the original corner or its accessories. A North-South paved road (Norwich Road) now runs over the corner position. Property owners on both sides of the Norwich Road, for many years, have accepted it as defining the North South ¼ line.

I used the Norwich Road to define the East - West position of the corner and placed it on line between Section corners East & West. This position works well with GLO distance to the Section corner to the West: (2649.9 GLO) (2649.50 Meas.). The distance from this position to the Section corner to the East is short (2649.9 GLO) (2608.56 Meas.) A cliff-like ravine between these two corners may account for the difference.

Research on file with County Remonumentation Representative.


PEER GROUP APPROVED
Earl W. Applbaum
 COUNTY REPRESENTATIVE 6-09-99

C. Description of monument for corner and accessories established to perpetuate locating the position of the corner:

Corner is a 5/8" Iron Pin with a 3" diameter aluminum cap stamped to read: County Remonumentation; T51N, R40W; ¼; S.11, S.14; 1999; P.S. 37273. I also set a reference Monument (RM) to the East, a 2 ½" by 30" aluminum pipe with a 3" diameter aluminum cap stamped to indicate that the corner is N89°W a distance of 52.03 feet. Corner falls in centerline of Norwich Road.

Witnesses:

NGS Benchmark C-13	N48°18'26"E	73.77'
RM	S89°01'08"E	52.03'
14' Soft Maple	S56°E	69.45'
12' Poplar	N87°W	51.79'
N ¼ Corner Sec. 11	N00°14'17"W	5275.12'

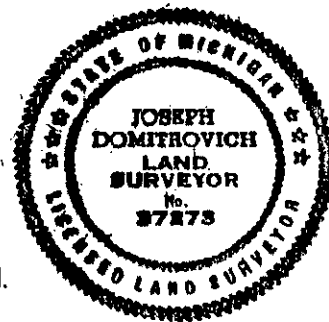

NOTE: Bearings to witness objects are magnetic. Distances are to a nail in side of the witness object unless noted.

Signed by Joseph C. Domitrovich

Date 6/09/99

Surveyor's Michigan License No. 37273