

**LAND CORNER RECORDATION CERTIFICATE**  
**Filing Requirement of Act 74, Mich. P.A. 1970**

For corners in Ontonagon Located In: \_\_\_\_\_ Corner Code # \_\_\_\_\_  
 (County)

|                                      |   |       |   |       |       |
|--------------------------------------|---|-------|---|-------|-------|
| 1. Public Land Survey                | T | 51N   | R | 40W   | K-2   |
|                                      | T | _____ | R | _____ | _____ |
|                                      | T | _____ | R | _____ | _____ |
|                                      | T | _____ | R | _____ | _____ |
| 2. Property Controlling in Section   | S | _____ | T | _____ | R     |
|                                      | S | _____ | T | _____ | R     |
| 3. Miscellaneous Property in Section | S | _____ | T | _____ | R     |
|                                      | S | _____ | T | _____ | R     |

**SURVEY & REMONUMENTATION**

MAY 22 1997

**COMMISSION**

Register of Deeds Stamp & File Number

4. Lot No. \_\_\_\_\_, Recorded Plat \_\_\_\_\_  
 5. Private Claims \_\_\_\_\_

| A  | B  | C  | D  | E  | F  | G  | H | I | J | K | L | M |
|----|----|----|----|----|----|----|---|---|---|---|---|---|
| 2  | 6  | 5  | 4  | 3  | 2  | 1  |   |   |   |   |   |   |
| 3  |    |    |    |    |    |    |   |   |   |   |   |   |
| 4  | 7  | 8  | 9  | 10 | 11 | 12 |   |   |   |   |   |   |
| 5  |    |    |    |    |    |    |   |   |   |   |   |   |
| 6  | 18 | 17 | 16 | 15 | 14 | 13 |   |   |   |   |   |   |
| 7  |    |    |    |    |    |    |   |   |   |   |   |   |
| 8  | 19 | 20 | 21 | 22 | 23 | 24 |   |   |   |   |   |   |
| 9  |    |    |    |    |    |    |   |   |   |   |   |   |
| 10 | 30 | 29 | 28 | 27 | 26 | 25 |   |   |   |   |   |   |
| 11 |    |    |    |    |    |    |   |   |   |   |   |   |
| 12 | 31 | 32 | 33 | 34 | 35 | 36 |   |   |   |   |   |   |
| 13 |    |    |    |    |    |    |   |   |   |   |   |   |

I, Joseph C. Domitrovich, in a field survey on July 11, 1996, do hereby certify that under requirements of P.A. 74, Michigan P.A. of 1970, the corner points mentioned in lines 1 and 2 above were in conformance with regulations and rules therefore as required in the current manual of survey instructions of the United States Department of the Interior, Bureau of Land Management or by a decree of a Court of Law and/or that the corner points mentioned in lines 3, 4 and 5 above were in conformance with the rules of the Michigan Board of Professional Surveyors or by a Decree of a Court of Law; established, re-established, monumented, re-monumented, recovered, found as expressed below:

**NOTE: Not more than 4 corners, all in the same town and range, may be recorded on this certificate.**

**A. Description of original monument and accessories and/or subsequent restoration:**

(K-2) 1/4 Corner Sections 2 and 1, T51N, R40W

1845 - William A. Burt set Fir post  
 6" Y. Birch N 43° E 28 links  
 4" B. Ash N 62° W 23 links

1922-23 E.J. Donnelly C.E., in original Notes at Ontonagon County Register of Deeds and Map on file at Ontonagon County Abstract and Title, noted that the Yellow Birch B.T. was still standing and that he set a stake at the corner from it. He also noted a distance of 2638.6' North of the Section corner to South. He also noted this corner was 2616.7' South of Standard Corner to North.

1932 - Ned Hawley, Timber Cruiser, noted in his personal copy of the original notes that he put a 1/2" x 6' iron pipe at stake and that the Yellow Birch B.T. was now a 4' high 10" stump with knife marks faintly visible.

**B. Description of corner evidence found and/or method applied in restoring or reestablishing corner:**

I found a 3/4" O.D. pipe 5' long at the corner position. I also found a rotten stump hole surrounded by a ring of soft Maples at the record Bearing and distance of Yellow Birch B.T. (From pipe.).  
 Measured distances North (2613.36') and South (2635.91') are consistent with Donnelly distances.

I therefore accepted the position of the iron pipe as the true 1/4 corner position, and monumented it as such.

Research on file with County Remonumentation Representative.


PEER GROUP APPROVED  
*Earl W. Applebury*  
 COUNTY REPRESENTATIVE

**C. Description of monument for corner and accessories established to perpetuate locating the position of the corner:**

Corner is a 3/4" x 36" aluminum rod with a 3" diameter aluminum cap stamped to read: 1/4 S.2; S.1; T.51N., R.40W.; 1996; P.S. 37273.

**Witnesses:**

|                 |         |                        |
|-----------------|---------|------------------------|
| 11" Basswood    | N 60° E | 13.28'                 |
| 5" Hard Maple   | S 47° E | 4.56'                  |
| 14" Cedar       | S 72° W | 5.99' (Existing Blaze) |
| 14" White Ash   | N 73° W | 37.97'                 |
| Steel Sign Post | North   | 1.20'                  |

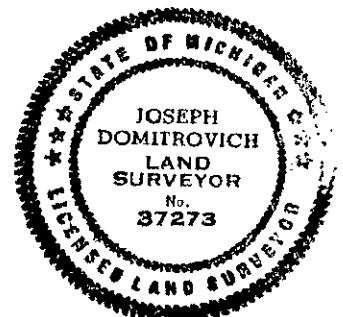

**NOTE: Bearings are magnetic. Distances are to nail in side of witness objects unless noted.**

Signed by Joseph C. Domitrovich Date 9/12/96  
 Surveyor's Michigan License No. 37273