

LAND CORNER RECORDATION CERTIFICATE
 Filing Requirement of Act 74, Mich. P.A. 1970

For corners in Ontonagon Located In: _____ Corner Code # _____
 (County)


- | | | | | | | |
|--------------------------------------|---|------------|---|------------|------------|-------|
| 1. Public Land Survey | T | <u>51N</u> | R | <u>40W</u> | <u>K-3</u> | |
| | T | _____ | R | _____ | _____ | |
| | T | _____ | R | _____ | _____ | |
| | T | _____ | R | _____ | _____ | |
| 2. Property Controlling in Section | S | _____ | T | _____ | R | _____ |
| | S | _____ | T | _____ | R | _____ |
| 3. Miscellaneous Property in Section | S | _____ | T | _____ | R | _____ |
| | S | _____ | T | _____ | R | _____ |
4. Lot No. _____, Recorded Plat _____
 5. Private Claims _____

SURVEY & REMONUMENTATION

MAY 22 1997

COMMISSION

Register of Deeds Stamp & File Number

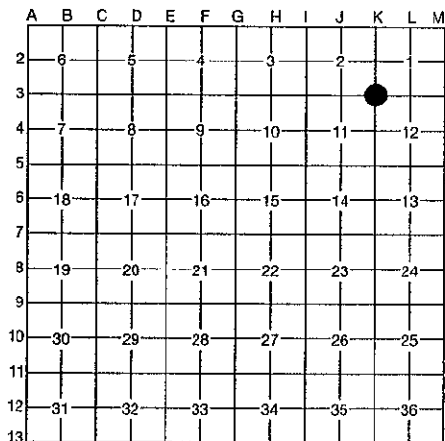

I, Joseph C. Domitrovich, in a field survey on August 29, 1996, do hereby certify that under requirements of P.A. 74, Michigan P.A. of 1970, the corner points mentioned in lines 1 and 2 above were in conformance with regulations and rules therefore as required in the current manual of survey instructions of the United States Department of the Interior, Bureau of Land Management or by a decree of a Court of Law and/or that the corner points mentioned in lines 3, 4 and 5 above were in conformance with the rules of the Michigan Board of Professional Surveyors or by a Decree of a Court of Law; established, re-established, monumented, re-monumented, recovered, found as expressed below:

NOTE: Not more than 4 corners, all in the same town and range, may be recorded on this certificate.

A. Description of original monument and accessories and/or subsequent restoration:
(K-3) Corner of Sections 1, 2, 11 & 12, T51N, R40W

- 1845 - William A. Burt set Cedar post
 10" Fir S 51° E 12 links
 12" Y. Birch N 60° W 30 links (19.80')
- 1923 - E.J. Donnelly C.E., in map on file at Ontonagon County Abstract and Title, noted that there was a B.T. standing here after the new road was built. He also noted a distance of 2638.6' north to the 1/4 corner.
- 1951 - Ned Hawley, Timber Cruiser, noted in his personal copy of the original field notes: "1/15/51, standing, iron pipe at B.T."


B. Description of corner evidence found and/or method applied in restoring or reestablishing corner:
 I found a 3/4" square top, twist-iron "Lightning Rod", same type as set by E.J. Donnelly elsewhere in the County, in the middle of the now grown over "Nightmare" road. It worked well with 1/4 and Section corner to west and Donnelly distance (2635.91m.) to north. I also found a 1" x 6" high iron pipe N 58° W 19.40' from the corner (There are remains of rotten stump at base of pipe.) and a blazed cedar with dates written in blaze facing the corner. (Dates from '34 to '60 including "N.H. 1/15/51")
 I accepted the position of the Lightning rod as the true corner and monumented it as such.

Research on file with County Remonumentation Representative.

C. Description of monument for corner and accessories established to perpetuate locating the position of the corner:
 Corner is a 2" x 30" aluminum pipe with a 3" diameter aluminum cap stamped to read: S.1, S.2, S.11, S.12; T.51N., R.40W.; 1996; P.S. 37273.

- Witnesses:**
- | | | |
|-----------------|---------|-------------------------|
| 8" Basswood | N 69° E | 23.47' |
| 7" White Ash | S 45° E | 24.18' |
| 14" Cedar | S 60° W | 18.18' (Existing Blaze) |
| 7" Black Ash | N 72° W | 17.44' |
| 1" Pipe 6' high | N 58° W | 19.40' |

PEER GROUP APPROVED
Earl W. Applbaum
 COUNTY REPRESENTATIVE 9-12-96

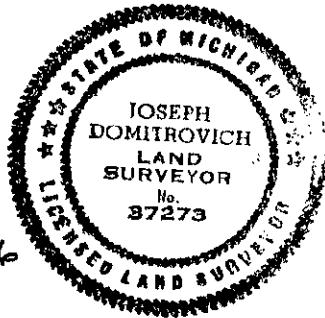

NOTE: Bearings are magnetic. Distances are to nail in side of witness objects unless noted.

Signed by J. C. Domitrovich Date 9/12/96
 Surveyor's Michigan License No. 37273