

**LAND CORNER RECORDATION CERTIFICATE**  
 Filing Requirement of Act 74, Mich. P.A. 1970

For corners in Ontonagon Located In: \_\_\_\_\_ Corner Code # \_\_\_\_\_  
 (County)

1. Public Land Survey T 51N R 40W L-1  
 T \_\_\_\_\_ R \_\_\_\_\_  
 T \_\_\_\_\_ R \_\_\_\_\_  
 T \_\_\_\_\_ R \_\_\_\_\_

2. Property Controlling S \_\_\_\_\_ T \_\_\_\_\_ R \_\_\_\_\_  
 in Section S \_\_\_\_\_ T \_\_\_\_\_ R \_\_\_\_\_

3. Miscellaneous S \_\_\_\_\_ T \_\_\_\_\_ R \_\_\_\_\_  
 Property in Section S \_\_\_\_\_ T \_\_\_\_\_ R \_\_\_\_\_

4. Lot No. \_\_\_\_\_, Recorded Plat \_\_\_\_\_

5. Private Claims \_\_\_\_\_

**SURVEY &  
 REMONUMENTATION**  
 MAY 22 1997  
**COMMISSION**  
 Register of Deeds Stamp & File Number

A	B	C	D	E	F	G	H	I	J	K	L	M
2	6	5	4	3	2							
3												
4	7	8	9	10	11	12						
5												
6	18	17	16	15	14	13						
7												
8	19	20	21	22	23	24						
9												
10	30	29	28	27	26	25						
11												
12	31	32	33	34	35	36						
13												

I, Joseph C. Domitrovich, in a field survey on August 7, 1996, do hereby certify that under requirements of P.A. 74, Michigan P.A. of 1970, the corner points mentioned in lines 1 and 2 above were in conformance with regulations and rules therefore as required in the current manual of survey instructions of the United States Department of the Interior, Bureau of Land Management or by a decree of a Court of Law and/or that the corner points mentioned in lines 3, 4 and 5 above were in conformance with the rules of the Michigan Board of Professional Surveyors or by a Decree of a Court of Law; established, re-established, monumented, re-monumented, recovered, found as expressed below:

**NOTE: Not more than 4 corners, all in the same town and range, may be recorded on this certificate.**

A. Description of original monument and accessories and/or subsequent restoration:

(L-1) North 1/4 corner Section 1, T51N, R40W.

Corner was not set in original survey but was established midway and on line between NE Corner of Section 1 and NW Corner of Section 1 (Closing Corner).

B. Description of corner evidence found and/or method applied in restoring or reestablishing corner:

I re-established this corner midway between the NW Corner of Section 1 (Closing Corner) and the NE Corner Section 1 and on line between the South 1/4 corner Section 36, (T52N, R40W) and the NE Corner Section 1.

Research on file with County Remonumentation Representative.


**PEER GROUP APPROVED**  
*Earl W. Applekamp*  
 COUNTY REPRESENTATIVE 08-08-96

C. Description of monument for corner and accessories established to perpetuate locating the position of the corner:

Corner is a 3/4" x 48" aluminum rod with a 3" diameter aluminum cap stamped to read: T.51N., R.40W.; 1/4; S.1; C.C.; 1996; P.S. 37273. Corner falls 45' west of west edge of Ontonagon River.

Witnesses:

7" White Ash	N 13° E	25.00'	
Twin 15" White Ash	S 40° E	33.30'	
Steel Sign Post	South	0.87'	
3/4" alum. capped rod in 2" pipe	West	19.48'	(South 1/4 Corner Section 36, T52N, R40W)
Iron Bolt w/square nut	N 53° W	20.56'	

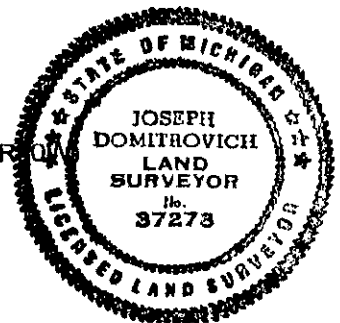

**NOTE: Bearings are magnetic. Distances are to nail in side of witness objects unless noted.**

Signed by J. C. Domitrovich Date 8/8/96  
 Surveyor's Michigan License No. 37273